

Harrison
J178
4-25-74

MISSISSIPPI
 BOARD OF WATER COMMISSIONERS **CODED**
 416 North State Street
 Jackson, Mississippi 39201

WATER WELL DRILLERS LOG

4-25 19 74 Sutter Well Works Harrison
 date well completed firm name county well located

LANDOWNER: Russell Nease

description of formations encountered	from	to
<u>Clay & Sand</u>	<u>0</u>	<u>5</u>
<u>Shale - Clay</u>	<u>5</u>	<u>148</u>
<u>Clay - sand streaks</u>	<u>148</u>	<u>302</u>
<u>Clay</u>	<u>302</u>	<u>450</u>
<u>Sand</u>	<u>450</u>	<u>491</u>
<u>Clay</u>	<u>491</u>	<u>503</u>
<u>Sand</u>	<u>503</u>	<u>546</u>

32ND AVE

Geelford Miss.
 (mailing/address)

WELL LOCATION:
 sec. 35 T 7 S R 13 W
2 miles N of Helena
 (distance) (direction) (nearest town)

WELL PURPOSE: Home
 (home, irrigation, municipal, industrial)

WELL COMPLETION DATA:

- (1) diameter (inches) 2 1/2" x 3" x 4"
- (2) total depth (feet) 546'
- (3) static water level (feet) 29' below above top of ground.
- (4) casing Galv. 526'
 (material) (depth)
3" x 4" If telescope see back.
 (size)
- (5) screen 20' 526'
 (length) (depth to top)
2 1/2" Stainless Steel
 (size) (material)
- (6) pump 1 20
 (HP) (yield gpm)
elec
 (type power)
- (7) electric log no
 (yes or no)

CODED

(organization running log)

(8) how well bottom plugged B.P. Value

DRILLERS REMARKS:

RECEIVED
JUL - 5 1974


If well telescopes please sketch and show depths.

GROUND LEVEL

168' of 4" pipe
(42' black Palauco gals.)

358' of 3" black pipe

20' of 2 1/2" stainless
Steel strainer

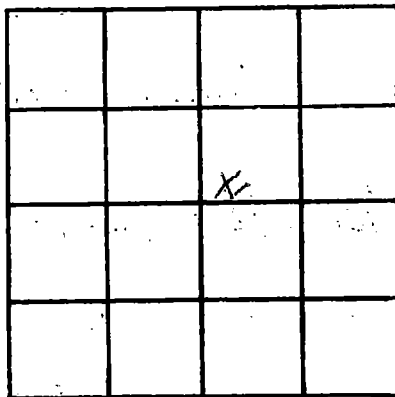

SECTION 35

Please indicate well location X.

ADDITIONAL INFORMATION

If more than one screen,
show locations of each on sketch.