

HARRISON
J 180
3-26-75

MISSISSIPPI
 BOARD OF WATER COMMISSIONERS
 416 North State Street
 Jackson, Mississippi 39201

WATER WELL DRILLERS LOG

CODED

3-26
 date well completed

1975 Bud Penton & Son
 firm name

Harrison
 county well located

LANDOWNER:

Willie E Knowles
 Rt. 1, P.O. Christian
 (mailing address)

description of formations encountered

	from	to
White Shale	0	60
White Sand	60	85
Blue Shale	85	475
Grey Sand	475	515

WELL LOCATION:

sec 12 T 7 N R 13 E
 10 miles N.E. of Kuhn
 (distance) (direction) (nearest town)

WELL PURPOSE: Home
 (home, irrigation, municipal, industrial)

WELL COMPLETION DATA:

- (1) diameter (inches) 2 in
- (2) total depth (feet) 515
- (3) static water level (feet) 16 below top of ground
- (4) casing PVC 505 (material) (depth)

(size) If telescope see back.

- (5) screen 2x10 505 (length) (depth to top)
- 2x10 PVC (size) (material)

- (6) pump 1/2 450 (HP) (yield gpm)

electric (type power)

- (7) electric log no (yes or no)

(organization running log)

- (8) how well bottom plugged Sand Shale

DRILLERS REMARKS:


RECEIVED

APR 3 1975

MISS. BD. OF WATER COMM

If well telescopes please sketch and show depths.

GROUND LEVEL

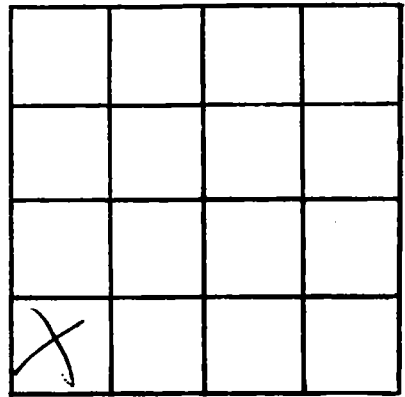

SECTION _____

Please indicate well location X.

ADDITIONAL INFORMATION

If more than one screen,
show locations of each on sketch.