

Harrison
 J 182
 2-17-75

MISSISSIPPI
 BOARD OF WATER COMMISSIONERS
 416 North State Street
 Jackson, Mississippi 39201

WATER WELL DRILLERS LOG

2-17 1975 Sutter Well Works Harrison
 date well completed firm name county well located

LANDOWNER: James Morgan
 Camille Village
 Pass Christian, Miss.

description of formations
 encountered

from to

Sand	0	70
Clay	70	192
Sand	192	226
Clay	226	229
Sand	229	244

(mailing address)

WELL LOCATION:

sec. 39 T 7 S R 13 W
 miles in DeLisle
 (distance) (direction) of (nearest town)

WELL PURPOSE: home
 (home, irrigation, municipal, industrial)

WELL COMPLETION DATA:

CODED

- (1) diameter (inches) 2"
- (2) total depth (feet) 244'
- (3) static water level (feet) 14' below top of ground.
- (4) casing gal. 139'
 (material) (depth)
 2" (size) if telescope see back.
- (5) screen 5' 239'
 (length) (depth to top)
 2" stainless steel
 (size) (material)
- (6) pump 1/2 10
 (HP) (yield gpm)
 elec.
 (type power)
- (7) electric log no
 (yes or no)

(organization running log)

B.P. Valve

(8) how well bottom plugged


DRILLERS REMARKS:

APR 29 1975

MISS. BD. OF WATER COMM.

If well telescopes please sketch and show depths.

GROUND LEVEL

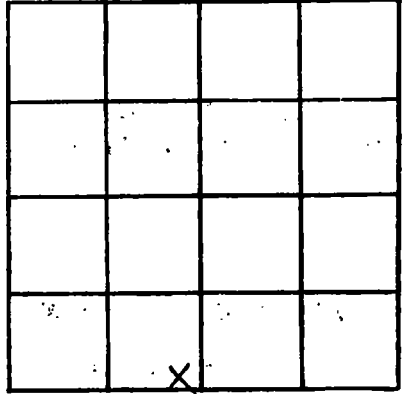

SECTION 39

Please indicate well location X.

ADDITIONAL INFORMATION

If more than one screen, show locations of each on sketch.