

HARRISON  
 J  
 1-18-78

MISSISSIPPI  
 BOARD OF WATER COMMISSIONERS  
 416 North State Street  
 Jackson, Mississippi 39201

CODED

WATER WELL DRILLERS LOG

1-18-78 date well completed      McNeil Well Works firm name      Harrison county well located

LANDOWNER: James Burlock  
 Rt. 2 Box 475H  
 P.C., Mo.  
 (mailing address)

WELL LOCATION:  
 sec. 4 T 7 N R 13 E  
 3 miles S of Vidalia  
 (distance) (direction) (nearest town)

WELL PURPOSE: none  
 (home, irrigation, municipal, industrial)

WELL COMPLETION DATA:  
 4" - 4"  
 (1) diameter (inches)  
 211-302'  
 (2) total depth (feet)  
 90' below top of ground  
 (3) static water level (feet)  
 5" Sch. 40 PVC 410'  
 (material) (depth)  
 (size) if telescope see back.  
 (5) screen 10' (length) (depth to top)  
 2" plastic (size) (material)  
 (6) pump 1 Submersible 25 (HP) (yield gpm)  
 electric (type power)  
 (7) electric log no (yes or no)  
 (organization running log)  
 (8) how well bottom plugged Sand Shale

description of formations encountered	from	to
red clay	0	30
w. pipe clay	30	47
R. sand	47	81
w. clay	81	166
slush	166	212
C. sand	212	251
y. sand	251	296
B. clay	296	338
slush	338	410
b. sand	410	430
B. clay	430	471
C. sand	471	502

RECEIVED


AUG 11 1978

DRILLERS REMARKS:

MISS. BD. OF WATER COMMISSIONERS

If well telescopes please sketch and show depths.

GROUND LEVEL

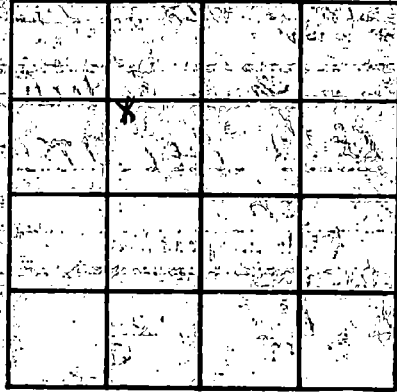

SECTION 4

Please indicate well location X.

ADDITIONAL INFORMATION

If more than one screen, show locations of each on sketch.