

MISSISSIPPI DEPARTMENT OF NATURAL RESOURCES

Bureau of Land and Water Resources

Southport Mall

P.O. Box 10631

Jackson, Mississippi 39209

WATER WELL DRILLERS LOG

COASTAL DRILLING & SERVICE CO.

CODED

HARRISON
J 191
5-11-79

date well completed 5/11/79 ROUTE 1 BOX 618 firm name Harrison county well located

BILOXI, MISS. 39532

LANDOWNER Bradford Home
Beat Line Rd
Long Beach Miss
(mailing address)

description of formations encountered	from	to
<u>top soil</u>	<u>1</u>	<u>2</u>
<u>Red Clay</u>	<u>2</u>	<u>15</u>
<u>Super Sand</u>	<u>15</u>	<u>20</u>
<u>Coarse white sand</u>	<u>40</u>	<u>65</u>
<u>Soft Blue Clay</u>	<u>65</u>	<u>210</u>
<u>fine water sand</u>	<u>210</u>	<u>260</u>
<u>Hard Blue Clay</u>	<u>260</u>	<u>460</u>
<u>fine water sand</u>	<u>460</u>	<u>495</u>
<u>good water sand</u>	<u>495</u>	<u>520</u>

WELL LOCATION:
sec. 12 T. 7 N. R. 13 E
Woff Rivers
(distance) (direction) (nearest town)

WELL PURPOSE: Home
(home, irrigation, municipal, industrial)

WELL COMPLETION DATA:
(1) diameter (inches) 4 1/2"
(2) total depth (feet) 520'
(3) static water level (feet) 35' below top of ground
(4) casing PVC (material) 505' (depth)
4 1/2" (size) If telescope see back.
(5) screen 15' (length) 505' (depth to top)
2" (size) PVC (material)
(6) pump one (HP) 20 (yield gpm)
Call (type power)
(7) electric log no (yes or no)
(organization running log)

(8) how well bottom plugged
2" lead weight holes
DRILLERS REMARKS: 19-B

DEPT. OF NATURAL RESOURCES
BUREAU OF LAND & WATER RESOURCES

OCT 31 1980

RECEIVED

If well telescopes please sketch and show depths.

GROUND LEVEL


160' 4" PK Casing

345' 2" PK Casing

15' 2" PK Screen

2" hard wall valve
2" 19-B

If more than one screen,
show locations of each on sketch.

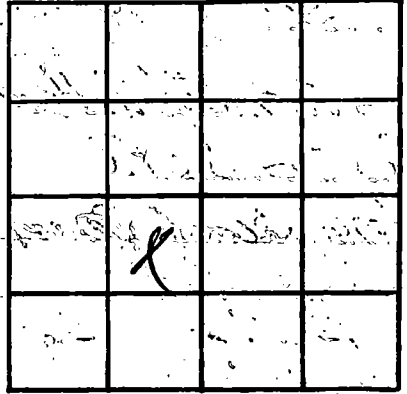

SECTION _____

Please indicate well location X.

ADDITIONAL INFORMATION

Multiple horizontal lines for additional information.