

MISSISSIPPI DEPARTMENT OF NATURAL RESOURCES

Bureau of Land and Water Resources

Southport Mall

P.O. Box 10631

Jackson, Mississippi 39209

WATER WELL DRILLERS LOG

COASTAL DRILLING & SERVICE CO.

CODED

HARRISON
J-192
9-24/80
9/22/80

date well completed 19

ROUTE 1 BOX 618

firm name

county well located

BRUNN, MISS. 39532

Harrison

Landowner: Highland Baptist Church

St 2 Box 171A Meridian

per Christian Jovin
(mailing address)

description of formations encountered

from

to

Top soil	1	3
Red Clay	3	40
Soft Blue Clay	40	90
fine water sand	90	120
Soft Blue Clay	120	240
fine water sand	240	280
Hard Blue Clay	280	400
fine water sand	400	510
Coarse water sand	510	540

WELL LOCATION:

sec. 22 T. 7 N. R. 13E
3.1 miles North of DeLade
(distance) (direction) (nearest town)

WELL PURPOSE:

(home, irrigation, municipal, industrial) Church

WELL COMPLETION DATA:

- (1) diameter (inches) 4 1/2"
- (2) total depth (feet) 540'
- (3) static water level (feet) 75' below top of ground.
- (4) casing PVC 525'
(material) (depth)
- 4 1/2" if telescope see back.
(size)
- (5) screen 15' 525'
(length) (depth to top)
- 2" PVC
(size) (material)
- (6) pump 1 1/2 25
(HP) (yield gpm)
- etc
(type power)
- (7) electric log no
(yes or no)

(organization running log)

DEPT. OF NATURAL RESOURCES
BUREAU OF LAND & WATER RESOURCES

JAN 12 1981

(8) how well bottom plugged
2" back wash valve

DRILLERS REMARKS: 19-B

RECEIVED

If well telescopes please sketch and show depths.

GROUND LEVEL

200' 4" PVC Casing


325' 2" PVC Casing

15' 2" PVC Screen

2nd bed mesh tubul

19-B

If more than one screen, show locations of each on sketch.

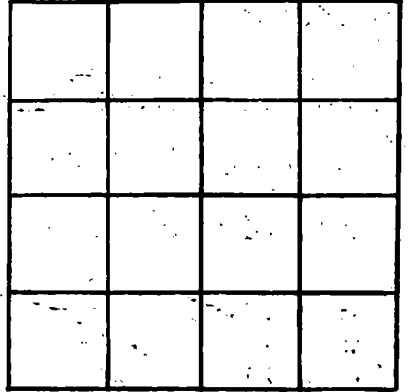

SECTION _____

Please indicate well location, X.

ADDITIONAL INFORMATION

Lined area for additional information.