

Harrison  
 J 193  
 9-16-81

MISSISSIPPI DEPARTMENT OF NATURAL RESOURCES  
 Bureau of Land and Water Resources  
 Southport Mall  
 P.O. Box 10631  
 Jackson, Mississippi 39209  
**WATER WELL DRILLERS LOG**

**CODED.**

9-16-1981 BRADEN Pump & Well Service, INC - HARRISON  
 date well completed firm name county well located  
 Rt. 1 Box 676 SAUCIER Ms. 39574

LANDOWNER:  
 DR. RICHARD BURMAN  
 #2 OAKLAWN PLANTATION Rd.  
 Pass Christian, Ms. 39571  
 (mailing address)

WELL LOCATION:  
 sec. 38 T 7 N R 13 E  
 1 1/2 miles N.E. of DELISLE  
 (distance) (direction) (nearest town)

WELL PURPOSE: HOME  
 (home, irrigation, municipal, industrial)

WELL COMPLETION DATA:

- (1) diameter (inches) 4 X 2
- (2) total depth (feet) 660
- (3) static water level (feet) 40 below top of ground.
- (4) casing PVC total  
 (material) (depth)  
 4 X 2 If telescope see back.  
 (size)
- (5) screen 10'  
 (length) (depth to top)  
 2" PVC Underbar  
 (size) (material)
- (6) pump 1 1/2 25  
 (HP) (yield gpm)  
 230  
 (type power)
- (7) electric log no  
 (yes or no)  
 (organization running log)
- (8) how well bottom plugged  
 2" sand shark

description of formations encountered	from	to
Clay	0	20
SAND	20	110
CLAY	110	120
SAND	120	155
CLAY	155	190
SAND	190	255
CLAY	255	370
SAND	370	430
CLAY	430	450
SAND	450	470
CLAY	470	480
SAND + CLAY	480	500
SAND	500	660

**CODED**

1st log rec'd 11/16/81 - without description listed. Had to return for info 11/16/81. Rec'd and filed.

DEPT. OF NATURAL RESOURCES  
 BUREAU OF LAND & WATER RESOURCES

DEC - 7 1981  
**RECEIVED**

DRILLERS REMARKS:

If well telescopes please sketch and show depths.


GROUND LEVEL

200'

640'  
2x10ft  
PVC screen  
850'  
2" tail pipe  
660'

2" Backwash  
check

If more than one screen,  
show locations of each on sketch.

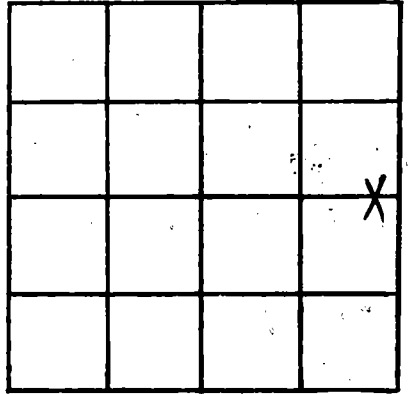

SECTION 38

Please indicate well location X.

ADDITIONAL INFORMATION

Lined area for additional information.