

MISSISSIPPI DEPARTMENT OF NATURAL RESOURCES

Bureau of Land and Water Resources

Southport Mall

P.O. Box 10631

Jackson, Mississippi 39209 **CODED**

WATER WELL DRILLERS LOG

TOM GRIFFITH

PLUMBING & WELL SERVICE, INC. Harrison

Harrison  
J 198  
7/15/84

7/15 19 84  
date well completed

300 MAYSON AVE.  
COLUMBIA, MS 39429

county well located

LANDOWNER: Corkrell Oil Co.

1212 Main Street

Houston, Texas 77002  
(mailing address)

WELL LOCATION:

sec. 33 T 7 N R 14 E  
4 miles W of Gulfport  
(distance) (direction) (nearest town)

WELL PURPOSE: oil field location  
(home, irrigation, municipal, industrial)

WELL COMPLETION DATA:

- (1) diameter (inches) 4"
- (2) total depth (feet) 220'
- (3) static water level (feet) 10' below above top of ground.
- (4) casing steel, 180'  
(material) (depth)  
4" if telescope see back.  
(size)
- (5) screen 40', 180'  
(length) (depth to top)  
4", slotted steel  
(size) (material)
- (6) pump air lift  
(HP) (yield gpm)  
diesel  
(type power)
- (7) electric log no  
(yes or no)  
n/a  
(organization running log)
- (8) how well bottom plugged welded

description of formations encountered

from

to

Chalk	0'	5'
Gravel	5'	40'
Chalk	40'	80'
Sand (fine)	80'	140'
Chalk	140'	180'
Sand	180'	220'

**CODED**

DEPT. OF NATURAL RESOURCES  
BUREAU OF LAND & WATER RESOURCES


AUG 7 1984

**RECEIVED**

DRILLERS REMARKS:

If well telescopes please sketch and show depths.

GROUND LEVEL

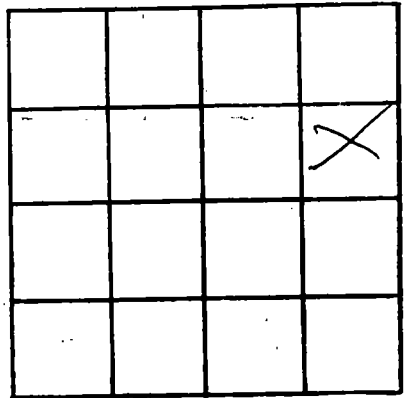

SECTION 33

Please indicate well location X.

ADDITIONAL INFORMATION

If more than one screen,  
show locations of each on sketch.