

MISSISSIPPI DEPARTMENT OF NATURAL RESOURCES
 Bureau of Land and Water Resources
 Southport Mall
 P.O. Box 10631
 Jackson, Mississippi 39209
WATER WELL DRILLERS LOG

CODED

Harrison
 J 201
 2/15/85

2/15/85 19 Lyman Well Co. Harrison
 date well completed firm name county well located

LANDOWNER: Al. Sadner

Rt. 3, Box 680

Pass Christian 39571
 (mailing address)

WELL LOCATION:

sec. 34 T. 7 N. R. 13 E.
3 miles north Delisle
 (distance) (direction) (nearest town)

WELL PURPOSE: Home
 (home, irrigation, municipal, industrial)

WELL COMPLETION DATA:

- (1) diameter (inches) 2"
 (2) total depth (feet) 580'
 (3) static water level (feet) 48 below above
 top of ground.
 (4) casing PVC 570'
 (material) (depth)
2"
 (size) If telescope see back.
 (5) screen 10' 570'
 (length) (depth to top)
2" PVC
 (size) (material)
 (6) pump N/A
 (HP) (yield gpm)

(type power)

- (7) electric log NO
 (yes or no)
NO
 (organization running log)

(8) how well bottom plugged sand
shark

DRILLERS REMARKS:

description of formations encountered

from to

<u>Red clay</u>	<u>0</u>	<u>40</u>
<u>Red sand</u>	<u>40</u>	<u>65</u>
<u>Red clay</u>	<u>65</u>	<u>100</u>
<u>Blue clay</u>	<u>100</u>	<u>250</u>
<u>White sand</u>	<u>250</u>	<u>265</u>
<u>Blue clay</u>	<u>265</u>	<u>540</u>
<u>Coarse sand</u>	<u>540</u>	<u>580</u>

CODED


RECEIVED

MAY 21 1985

Department of Natural Resources
 Bureau of Land and Water Resources

If well telescopes please sketch and show depths.

GROUND LEVEL

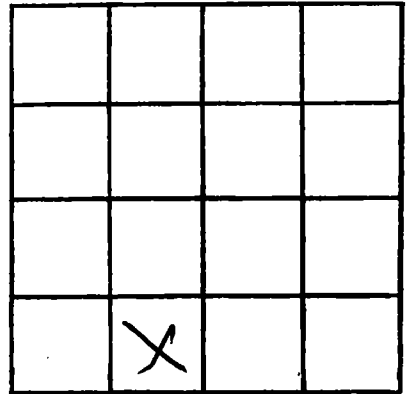

SECTION 34

Please indicate well location X.

ADDITIONAL INFORMATION

A series of horizontal lines for writing additional information.

If more than one screen, show locations of each on sketch.