

Harrison
 J 202
 2-23-85

MISSISSIPPI DEPARTMENT OF NATURAL RESOURCES
 Bureau of Land and Water Resources
 Southport Mall
 P.O. Box 10631
 Jackson, Mississippi 39209
WATER WELL DRILLERS LOG

CODED

2-23 1985 date well completed
 Mc Hill Pump Well firm name
 Harrison county well located

LANDOWNER: Edmond Shipp
Rt. 1 Box 4
Pass Christian
 (mailing address)
 WELL LOCATION:
 sec. 9 T. 7 N. R. 13 E.
8 miles N of Delisle
 (distance) (direction) (nearest town)
 WELL PURPOSE:
 (home, irrigation, municipal, industrial)

description of formations encountered	from	to
Mud CODED.	0	20
mud	20	40
Mud	40	60
Mud	60	80
Mud	80	100
Mud	100	120
Mud/Sand	120	140
Sand	140	160
Sand/Mud	160	180
Mud/Sand	180	200
Mud	200	220
Mud	220	240
Mud/Sand	240	260
Mud/Sand	260	280
Sand	280	300

WELL COMPLETION DATA:
 (1) diameter (inches) 2"
 (2) total depth (feet) 300'
 (3) static water level (feet) 40' below above top of ground.
 (4) casing Pvc Sch. 40, 290'
 (material) (depth)
 (size) if telescope see back.
 (5) screen 10', 290'
 (length) (depth to top)
2", Sch. 80 - 6 slot
 (size) (material)
 (6) pump 1 (HP) 8 (yield gpm)
FLEC
 (type power)
 (7) electric log (yes or no)
 (organization running log)
 (8) how well bottom plugged Seal


RECEIVED
 MAY 31 1985

Department of Natural Resources
 Bureau of Land & Water Resources

DRILLERS REMARKS:

If well telescopes please sketch and show depths.

GROUND LEVEL

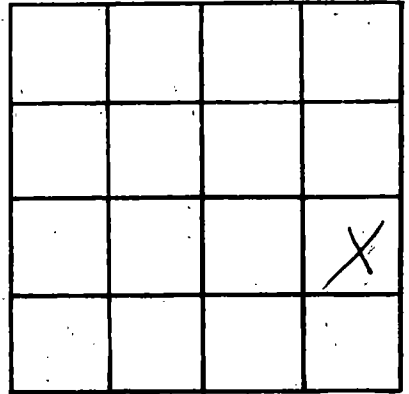

SECTION _____

Please indicate well location X.

ADDITIONAL INFORMATION

If more than one screen, show locations of each on sketch.