

MISSISSIPPI DEPARTMENT OF NATURAL RESOURCES

Bureau of Land and Water Resources

Southport Mall

P.O. Box 10631

Jackson, Mississippi 39209

WATER WELL DRILLERS LOG

CODED

Harrison
J203
12-20-84

12-20

1984

Mc Hill Well Works

Harrison

date well completed

firm name

county well located

LANDOWNER: Allen B. Albrecht

description of formations encountered

from

to

220 Long Ave.

Long Beach, Ms. 39560
(mailing address)

WELL LOCATION:

sec. 23 T 7 N R. 13 E
(distance) miles (direction) of Delistia
(nearest town)

WELL PURPOSE:
(home, irrigation, municipal, industrial)

WELL COMPLETION DATA:

- (1) diameter (inches) 2"
- (2) total depth (feet) 540'
- (3) static water level (feet) 40 below top of ground.
- (4) casing Pvc Sch 40, 530'
(material) (depth)

(size) if telescope see back.

- (5) screen 10', 530'
(length) (depth to top)
- 2", Sch 80 6 slot
(size) (material)

- (6) pump 1, 8
(HP) (yield gpm)

Elec.
(type power)

- (7) electric log (yes or no)

(organization running log)

- (8) how well bottom plugged Seal


DRILLERS REMARKS:

RECEIVED
MAY 31 1985
Department of Natural Resources
Bureau of Land & Water Resources

description of formations encountered	from	to
Mud	0	20
Mud/Sand	20	40
Sand	40	60
Sand	60	80
Sand/Mud	80	100
Mud	100	120
Mud	120	140
Mud	140	160
Mud	160	180
Mud/Sand	180	200
Mud	200	220
Mud/Sand	220	240
Sand/Mud	240	260
Mud	260	280
Mud	280	300
Mud/Sand	300	320
Mud	320	340
Mud	340	360
Sand/Mud	360	380
Mud/Sand	380	400
Sand/Mud	400	420
Mud	420	440
Mud	440	460
Mud	460	480
Sand/Mud	480	500
Mud/Sand	500	520
Sand	520	540

If well telescopes please sketch and show depths.

GROUND LEVEL

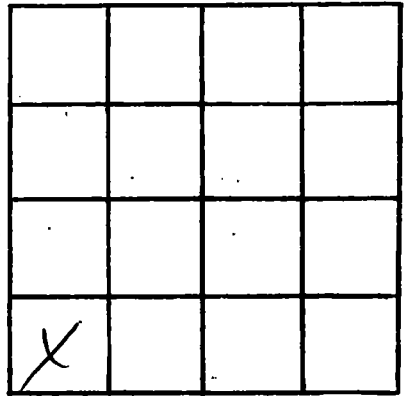

SECTION _____

Please indicate well location X.

ADDITIONAL INFORMATION

If more than one screen, show locations of each on sketch.