

MISSISSIPPI DEPARTMENT OF NATURAL RESOURCES

Bureau of Land and Water Resources

Southport Mall

P.O. Box 10631

Jackson, Mississippi 39209 CODED

WATER WELL DRILLERS LOG

Harrison  
J 204  
3/2/85

3-2-1985  
date well completed

Mc Hill Well Works  
firm name

Harrison  
county well located

LANDOWNER: Florio Bundoff  
Rt. 3 Box 650  
Pass Christian, Ms. 39571  
(mailing address)

WELL LOCATION:  
sec. 33 T. 7 N. R. 13 E.  
7 miles NW of Delisle  
(distance) (direction) (nearest town)

WELL PURPOSE:  
(home, irrigation, municipal, industrial)

WELL COMPLETION DATA: 500'-2"  
70'-1"

- (1) diameter (inches) 2 1/4"
- (2) total depth (feet) 580'
- (3) static water level (feet) 70' below above top of ground.
- (4) casing Pvc. Sch. 40, 570'  
(material) (depth)  
(size) If telescope see back.
- (5) screen 10', 570'  
(length) (depth to top)  
2", Sch 80, 6 slot  
(size) (material)
- (6) pump 1, 8  
(HP) (yield gpm)  
Elec.  
(type power)
- (7) electric log                       
(yes or no)  
    
(organization running log)
- (8) how well bottom plugged SEAL

description of formations encountered	from	to
Mud	0	20
Mud / Sand / Rock	20	40
Sand	40	60
Sand / Gravel	60	80
Sand / Gravel	80	100
Sand	100	120
Mud	120	140
Mud	140	160
Sand / Mud	160	180
Mud / Sand	180	200
Sand / Mud	200	220
Sand	220	240
Sand	240	260
Sand	260	280
Sand / mud	280	300
Mud	300	320
Mud	320	340
Mud	340	360
Mud	360	380
Mud	380	400
Mud	400	420
Mud	420	440
Mud / Sand	440	460
Mud	460	480
Mud	480	500
Mud	500	520
Mud	520	540
Mud / Sand	540	560
Sand	560	580


RECEIVED  
JUN - 4 1985

DRILLERS REMARKS:   

Department of Natural Resources  
Bureau of Land & Water Resources

If well telescopes please sketch and show depths.

GROUND LEVEL

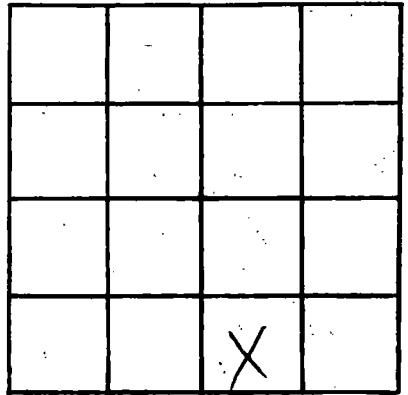

SECTION \_\_\_\_\_

Please indicate well location X.

ADDITIONAL INFORMATION

Lined area for providing additional information.

If more than one screen, show locations of each on sketch.