

MISSISSIPPI DEPARTMENT OF NATURAL RESOURCES

Bureau of Land and Water Resources

Southport Mall

P.O. Box 10631

Jackson, Mississippi 39209

WATER WELL DRILLERS LOG

CODED

Harrison
J 208
3/25/85

3-25 1985 McTell Well Works Harrison
date well completed firm name county well located

LANDOWNER: Samuel Deby
2 Northwood Drive
Long Beach
(mailing address)

WELL LOCATION:
sec 32 T 7 N R 13 E
6.5 miles NW of Delisle
(distance) (direction) (nearest town)

WELL PURPOSE:
(home, irrigation, municipal, industrial)

- WELL COMPLETION DATA:
- (1) diameter (inches) 4" 1/2" ^{200"-4"} ^{380"-2"}
 - (2) total depth (feet) 500'
 - (3) static water level (feet) 50' below above top of ground.
 - (4) casing Sch. 40 PIC. 490'
(material) (depth)
 - (size) If telescope see back.
 - (5) screen 10' 490'
(length) (depth to top)
 - 2" Sch. 80 6 slot
(size) (material)
 - (6) pump 1 7
(HP) (yield gpm)
 - Elec
(type power)
 - (7) electric log _____
(yes or no)
 - _____
(organization running log)
 - (8) how well bottom plugged Sand
Shack

description of formations encountered	from	to
Mud	0	20
Mud/Sand. CODED	20	80
Mud	80	100
Mud/Sand	100	120
Mud	120	150
Mud/Sand	180	200
Sand	200	220
Sand/Mud	220	240
Mud/Sand	240	260
Mud	260	320
mud/sand	320	340
Sand	340	380
Mud	380	420
Sand	420	480
Sand/gravel	480	500


RECEIVED
JUN 24 1985

DRILLERS REMARKS:

Department of Natural Resources
Bureau of Land & Water Resources

If well telescopes please sketch and show depths.

GROUND LEVEL

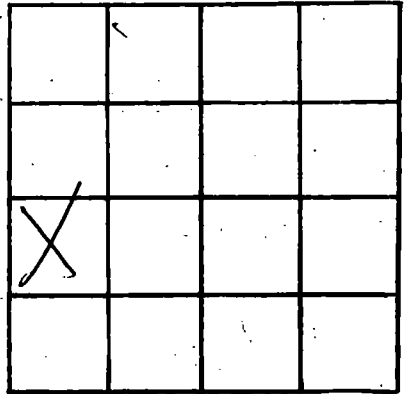

SECTION _____

Please indicate well location X.

ADDITIONAL INFORMATION

If more than one screen, show locations of each on sketch.