

MISSISSIPPI DEPARTMENT OF NATURAL RESOURCES

Bureau of Land and Water Resources

Southport Mall

P.O. Box 10631

Jackson, Mississippi 39209

WATER WELL DRILLERS LOG

CODED

HARRISON
5209

Feb 24 1986
date well completed

M'Heel Pump & Well Harrison
firm name

county well located

LANDOWNER: Tom Ledet
Rt. 2 Box 299-C
Exp. Mrs.
Red Oak Rd.
(mailing address)

description of formations encountered	from	to
<u>sand - gravel</u>	<u>0</u>	<u>50</u>
<u>mud</u>	<u>50</u>	<u>120</u>
<u>sand</u>	<u>120</u>	<u>150</u>
<u>mud</u>	<u>150</u>	<u>280</u>
<u>sand</u>	<u>280</u>	<u>310</u>
<u>mud</u>	<u>310</u>	<u>400</u>
<u>sand</u>	<u>400</u>	<u>430</u>
<u>mud</u>	<u>430</u>	<u>470</u>
<u>C. sand</u>	<u>470</u>	<u>540</u>

WELL LOCATION:
sec. 1 T. 7 N. R. 13 E.
6 miles SW of Lumberton
(distance) (direction) (nearest town)

WELL PURPOSE:
(home, irrigation, municipal, industrial)

WELL COMPLETION DATA:

(1) diameter (inches) 2"

(2) total depth (feet) 540'

(3) static water level (feet) _____ below top of ground above

(4) casing Sch. 40 530'
(material) (depth)

_____ (size) If telescope see back.

(5) screen 10'
(length) (depth to top)

2" (size) Sch. 80 (material)

(6) pump _____ (HP) _____ (yield gpm)


electric (type power)

(7) electric log no
(yes or no)

_____ (organization running log)

(8) how well bottom plugged good
seal

CODED

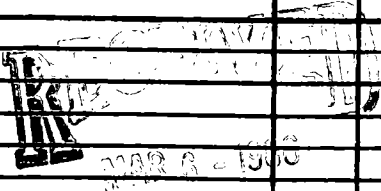

Department of Natural Resources
Bureau of Land & Water Resources

DRILLERS REMARKS:

If well telescopes please sketch and show depths.

GROUND LEVEL

SECTION _____

Please indicate well location X.

ADDITIONAL INFORMATION

If more than one screen, show locations of each on sketch.