

**MISSISSIPPI DEPARTMENT OF NATURAL RESOURCES**

Bureau of Land and Water Resources

**CODED**

P.O. Box 10631  
Jackson, Mississippi 39209  
**WATER WELL DRILLERS LOG**

COUNTY WELL LOCATED <b>Harrison</b>	
WELL NUMBER <b>J 210</b>	CODED
DATE WELL COMPLETED <b>Dec 19 1986</b>	

PERMIT NUMBER
NAME OF DRILLING FIRM <b>Hyman Well Co</b>

NAME & MAILING ADDRESS OF LANDOWNER  
**West. H.C. Ballpark**  
**P.O. Drawer CC**  
**Gulfport, MS 39501**

WELL LOCATION:	SEC	TOWNSHIP	RANGE
	<b>16</b>	<b>7</b>	<b>N 13 E</b>

DISTANCE	DIRECTION	NEAREST TOWN
<b>3</b> Miles	<b>North</b>	<b>Odessa</b>

OTHER LANDMARK  
**3 miles North of Dupont Plant Site**  
WELL PURPOSE: Home, Irrigation, Municipal, Industrial, Fish Pond, etc.  
**Community Bull Park**

**WELL DATA**

Well Depth <b>435'</b>	Casing Diameter (In.) <b>4"</b>	Casing Length (Ft.) <b>415'</b>
Type of Casing <b>PVC</b>	Hole Depth <b>435'</b>	Depth to Static Water Level <b>95'</b>
TYPE OF COMPLETION: (Circle One or More): Gravel Packed, Underreamed, Telescoped, <input checked="" type="checkbox"/> <b>Natural Development</b> , Open Hole, Other		
Top of Lap Pipe or Reduction in Casing: <b>FEET</b> IF TELESCOPED OR MORE THAN ONE SCREEN, USE BACK PAGE		

**SCREEN DATA**

Diameter - Inches <b>4"</b>	Length - Feet <b>20'</b>	Slot Size - Inches <b>0.006</b>
Screen Type <b>Stainless rod base</b>	Depth to Bottom - Feet <b>435'</b>	

**PUMP DATA**

PUMP TYPE (Circle One):  
 **Submersible**, Turbine, Jet, Flowing Well,  
Other (Describe) \_\_\_\_\_

POWER TYPE (Circle One):  
 **Electric**, Tractor, Diesel, Gasoline, Butane,  
Other (Describe) \_\_\_\_\_

Pump Capacity (GPM) <b>70</b>	No. of Stages <b>11</b>	Setting Depth <b>147</b> FT.
----------------------------------	----------------------------	---------------------------------

PUMP TEST  
Well yielded \_\_\_\_\_ GPM with  
a drawdown of \_\_\_\_\_ ft.  
after \_\_\_\_\_ hours of pumping

**LOG DATA**

TYPE OF LOG RUN (Circle One):  
Electric, Gamma Ray, Density, Sonic, Neutron,  
Other (Describe)  **None**

Name of Organization Running Log

**GEOLOGIC DATA (Office Use Only)**

Surface Elev.	Geologic Unit	Unit Thickness	Depth to Top
Subs. SWL	Date	Analysis	Aquifer Test


Driller's Remarks  
**None**

DESCRIPTION OF FORMATIONS ENCOUNTERED	FROM	TO	FORMATIONS (Continued)	FROM	TO
<b>Sand Topsoil</b>	<b>0</b>	<b>2'</b>	<b>RECEIVED</b>  <b>AUG 25 1987</b>  Department of Natural Resources Bureau of Land & Water Resources		
<b>Red sand &amp; clay</b>	<b>2</b>	<b>8'</b>			
<b>clay</b>	<b>8'</b>	<b>18'</b>			
<b>Sand</b>	<b>18'</b>	<b>26'</b>			
<b>Blue clay</b>	<b>26'</b>	<b>318'</b>			
<b>Sand</b>	<b>318'</b>	<b>323'</b>			
<b>Blue clay</b>	<b>323'</b>	<b>404'</b>			
<b>Sand</b>	<b>404'</b>	<b>435'</b>			

IF MORE SPACE IS NEEDED, USE BACK

If well telescopes please sketch and show depths.

GROUND LEVEL

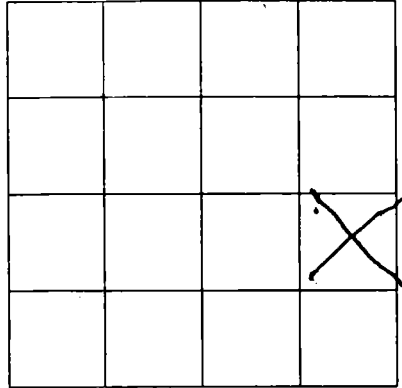

SECTION 16

Please indicate well location X.

ADDITIONAL INFORMATION

If more than one screen, show location of each on sketch.