

MISSISSIPPI DEPARTMENT OF NATURAL RESOURCES

Bureau of Land and Water Resources

Southport Mall

P.O. Box 10631

Jackson, Mississippi 39209

WATER WELL DRILLERS LOG

HARRISON
2153
274

3-5-88 19
 date well completed

R. J. Moore
 firm name

HARRISON
 county well located

LANDOWNER Cull Duke

RT 2 Box 5 Lazy Lakes

PASS CHRISTIAN, MS
 (mailing address) 39571

WELL LOCATION:
36 sec. 2 T. N R. 13 E.
6 miles N of Pass Christian
 (distance) (direction) (nearest town)

WELL PURPOSE:
 (home, irrigation, municipal, industrial)

WELL COMPLETION DATA:

- (1) diameter (inches) 4x3x2
- (2) total depth (feet) 560'
- (3) static water level (feet) 50' ^{below} _{above} top of ground.
- (4) casing PVC, 560'
 (material) (depth)
 (size) if telescope see back.
- (5) screen 20', 560'
 (length) (depth to top)
2", PVC
 (size) (material)
- (6) pump 3, 55
 (HP) (yield gpm)
E
 (type power)
- (7) electric log _____
 (yes or no)
 (organization running log)
- (8) how well bottom plugged Blw

description of formations encountered	from	to
TOP SOIL	0	20
Red white sand		
clay	20	40
white clay	40	60
sand + gravel	60	80
Blue clay	80	220
med Blue sand	220	240
Blue clay	240	360
fine sand	360	400
Blue clay	400	500
med sand	500	520
coarse sand	520	540
(blue sand & gravel)	54	560

160' - 4"
400' - 3"
20' - 2"

RECEIVED

MAR 31 1988

Department of Natural Resources
 Bureau of Land & Water Resources

DRILLERS REMARKS:


If well telescopes please sketch and show depths.

GROUND LEVEL

160'-4"

400'-3"

20'-2"

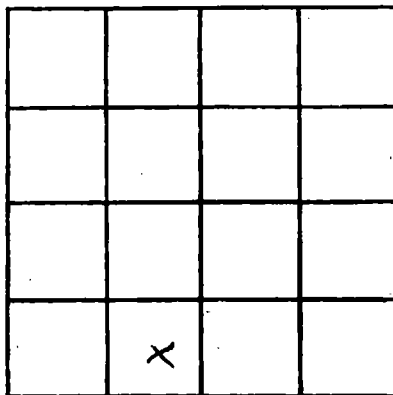

SECTION 36

Please indicate well location X.

ADDITIONAL INFORMATION

If more than one screen, show locations of each on sketch.