

State Well Report

Part 1

Mississippi Department of Environmental Quality
Office of Land and Water Resources
P.O. Box 10631
Jackson, MS 39289-0631
(601)961-5210
(601)354-6938 (fax)

For Office Use Only:

Aquifer: _____
Well #: **J-332**
L. S. Elevation: _____
E-log #: _____

County: Harrison **047**
Permit #: 0239
Driller: McGill Pump & Well
Date drilling completed: 03/22/05

McGill Pump and Well

State Law requires that this report be prepared by the driller in detail and filed with the Department within 30 days of completion of drilling of the well.

Well Owner Information	Well Location
Owner Name: <u>Jason Baxter</u>	Latitude: _____ Longitude: _____
Mailing Address: <u>11248 Sobony Rd.</u>	Method of Lat/Long (circle one): Conventional Survey, USGS quad, Hand-held GPS, Survey-grade GPS
<u>P.C. MS - 39571</u>	_____ 1/4 _____ 1/4 Sec <u>13</u> Twn <u>7S</u> Rng <u>13W</u>
City State Zip Code	Distance Direction Nearest Town
Telephone No. <u>(338) 424-0290</u>	<u>10</u> Miles <u>W</u> of <u>GPT</u>

Well Data

Purpose of Well (circle one) Home Industrial Public Supply Irrigation Fish Culture Other: _____

Date well drilling started: 03/22/05 Date well drilling completed: 03/22/05

If flowing, method of flow regulation: Valve _____ Other (describe) _____

Static Water Level: 100 feet above or below (circle one) land surface Date measured: 03/22/05

Method of Measurement (circle one) steel tape electric tape air line other: _____

Hole depth: 340 Well depth: 340 Well grouted to a depth of 10 feet

Type of grout (circle one): Cement Bentonite Mix

Casing length: 320 feet Casing diameter: 2" inches Type of casing: PVC

Screen length: 20 feet Screen diameter: 2" inches Type of screen: PVC

Screen slot size: 1.0006 inches Setting depth: From 320 feet to 340 feet

Type of completion (circle all applicable): Gravel packed Underreamed Telescoped Open hole Natural Development

Other (describe): _____

Top of lap pipe or reduction in casing: _____ feet. If telescoped or more than one screen, describe on back of page

Logs run (circle all applicable): No log run Electric Gamma Ray Density Sonic Neutron Other: _____

Name of organization running log(s): _____

I certify that the well was drilled, constructed, and completed in accordance with all applicable requirements of the Mississippi Department of Environmental Quality and/or the Mississippi Department of Health regulations and state laws.

McGill Pump & Well 0239
Print Name of Water Well Contractor and License No.

Michael M. Sullivan
Signature of Water Well Contractor

RECEIVED
APR 27 2005
BY: OLWR

If well telescopes please sketch below and show depths.

Ground Level


A large empty rectangular box with a thin black border, intended for sketching well telescopes and depths. The top of the box is aligned with the 'Ground Level' label. The box is mostly empty, with only a few faint lines.

J- 332

Description of Formations Encountered	From	To
SAND (WHITE)	0	60
MUD (Blue)	60	120
SAND (1")	120	160
MUD (1")	160	290
SAND (BLUE)	290	320

If more than one screen, show location of each on sketch

Sketch the property layout and include the following: 1) the well location; 2) any permanent structures on the property that may aid in locating the well; 3) any roads, power lines, or other items that may aid in locating the property and the well; 4) indicate direction.

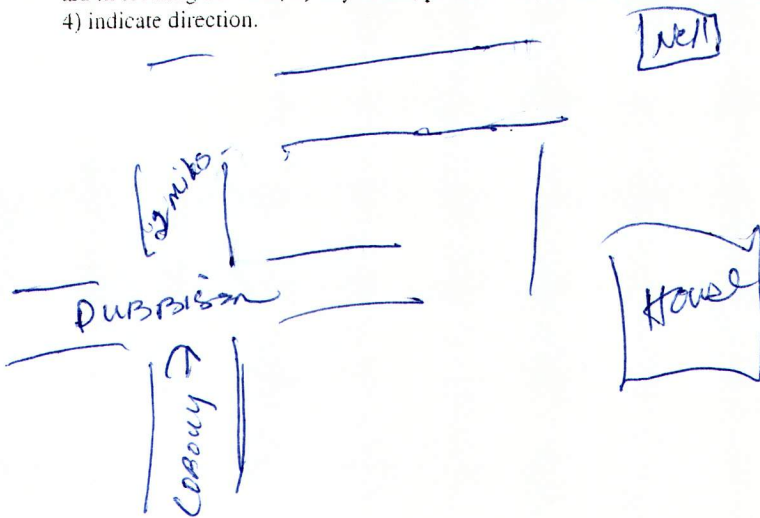

Landowner Name:

Jason Baxter

RECEIVED
APR 27 2005
BY: OLWR

STATE WELL REPORT

Part 2

Pump Installer's Completion Report
 Mississippi Department of Environmental Quality
 Office of Land and Water Resources
 P.O. Box 10631
 Jackson, MS 39289-0631
 (601)961-5210
 (601)354-6938 (fax)

For Office Use Only:

Aquifer: _____
 Well #: J-~~10~~ 332
 Elevation: _____

County: Harrison
 Permit #: 0239
 Driller: McGill Pump & Well
 Date completed: 03/22/05

This report should be prepared by the pump installer in detail and filed with the Department within 30 days of the installation of pump.

Well Owner Information	Well Location
Owner Name: <u>Jason Baxter</u>	Latitude: _____ Longitude: _____
Mailing Address: <u>11248 Coubag Rd.</u>	Method of Lat/Long (circle one): Conventional Survey, USGS quad, Hand-held GPS, Survey-grade GPS
<u>P.C. MS. 39571</u>	_____ 1/4 _____ 1/4 Sec <u>12</u> Twn <u>7S</u> Rng <u>13W</u>
City State Zip Code	Distance Direction Nearest Town
Telephone No. <u>308 424-0290</u>	<u>10</u> Miles <u>W</u> of <u>GPT.</u>

Pump Type Circle one	Power Type Circle one
Air Lift <input type="radio"/> Jet <input checked="" type="radio"/> Submersible	Diesel Engine Gasoline Engine Natural Gas
Bucket <input type="radio"/> Piston <input type="radio"/> Turbine	<input checked="" type="radio"/> Electric Motor <input type="radio"/> Hand <input type="radio"/> Tractor PTO
Centrifugal <input type="radio"/> Rotary <input type="radio"/> Flowing Well	Windmill Other (specify): _____
Other (specify): _____	Horse Power Rating of Motor: <u>1</u>
Date Pump Installed: <u>03/22/05</u>	Setting Depth: <u>120</u> feet
Rated Pump Capacity: <u>12</u> Gallons Per Minute	Number of Stages: <u>2</u>

Pump Test Data	Method of Measuring Water Level Circle one
Date Well Tested: <u>03/22/05</u>	Air Line Electric Measuring Line <input checked="" type="radio"/> Steel Tape
Static Water Level (A): <u>160</u> Feet Below Land Surface	Other (specify): _____
Pumping Water Level (B): <u>120</u> Feet Below Land Surface	For flowing well, measured shut in head: _____ feet
Drawdown [(B) - (A)]: <u>10</u> Feet Below Land Surface	Well yielded <u>12</u> GPM with a drawdown of
Test Pumping Rate: <u>12</u> Gallons Per Minute	<u>10</u> feet after <u>4</u> hours of pumping
Duration of Pump Test (minimum 4 hours): <u>4</u> hours	

I HEREBY CERTIFY that the above statements are true to the best of my knowledge.

McGill Pump & Well 0239

RECEIVED
 APR 27 2005
 BY: OLWR