

Harrison

County: Harrison
 Permit #: 0-209
 Driller: R. Mason
 Date drilling completed: 7/10/06

State Well Report
Part 1 - Driller's Log
 Mississippi Department of Environmental Quality
 Office of Land and Water Resources
 P.O. Box 10631
 Jackson, MS 39289-0631
 (601)961-5210
 (601)354-6938 (fax)

For Office Use Only:
 Aquifer: _____
 Well #: J-54342
 L. S. Elevation: _____
 E-log #: _____

State Law requires that this report be prepared by the license holder responsible for the work and filed with the Department at the above address within 30 days of completion of drilling of the well or borehole.

<p>Information on Well Owner (Landowner if borehole is not for a water well)</p> <p>Owner Name: <u>Ms. Neraise</u> Mailing Address: <u>118 Highway Rd.</u> <u>Lea Buoy</u> <u>Pass Christian, MS</u> City State Zip Code Telephone No. () _____</p>	<p>Well or Borehole Location</p> <p>Latitude: _____ Longitude: _____</p> <p>Method of Lat/Long (circle one): Conventional Survey, USGS quad, Hand-held GPS, Survey-grade GPS</p> <p><u>1/4</u> <u>1/4</u> Sec. <u>12</u> Twn <u>75</u> Rng <u>13W</u></p> <p>Distance Direction Nearest Town <u>1.2</u> Miles <u>N</u> of <u>Pass Christian</u></p>
--------------------------------------------------------------------------------------------------------------------------------------------------------------------------------------------------------------------------------------------------------------------------------------------------------------------------------------	------------------------------------------------------------------------------------------------------------------------------------------------------------------------------------------------------------------------------------------------------------------------------------------------------------------------------------------------------------------------------

Well / Borehole Data

Date drilling started: 7/9/06 Date drilling completed: 7/10/06 Hole depth: 325 Hole diameter: 4x2

Location of the source of any surface water used for drilling: Shed

Method of dosing and volume of Chlorine used in drilling and development: 1/2 lb per 1000 gal 59% chlorine

Logs run (circle all applicable): No log run Electric Gamma Ray Density Sonic Neutron Other: _____

Name of organization running log(s): N/A

Purpose of borehole (check one): Water Well Geotechnical/Geological Investigation Ground Source Heat Pump
 Seismic Survey Other (describe) _____

If drilling is not related to water well construction, skip the remainder of this block

Purpose of Well (check one): Home Industrial Public Supply Irrigation Fish Culture Other: _____

If a flowing well, method of flow regulation: Valve N/A Other (describe) _____

Static Water Level: 85 feet above below (circle one) land surface Date measured: 7/10/06

Method of Measurement (circle one) steel tape electric tape air line other plumb bob

Well depth: 325 Well grouted to a depth of 15 feet Type of grout (circle one): Best Cement Bentonite Mix

Casing length: 315 feet Casing diameter: 4x2 inches Type of casing: PVC

Screen length: 10 feet Screen diameter: 4x2 inches Type of screen: PVC

Screen slot size: .006 inches Setting depth: From 315 feet to 325 feet

Type of completion (circle all applicable): Gravel packed Underreamed Telescoped Open hole Natural Development

Other (describe): _____

Top of lap pipe or reduction in casing: N/A feet. *If telescoped or more than one screen, describe on next page*


Form: OLWR-SWR-1A

RECEIVED
 AUG 10 2006
 BY: OLWR

J-54
342

The sketch below only required for water wells

If well telescopes, show depths on sketch

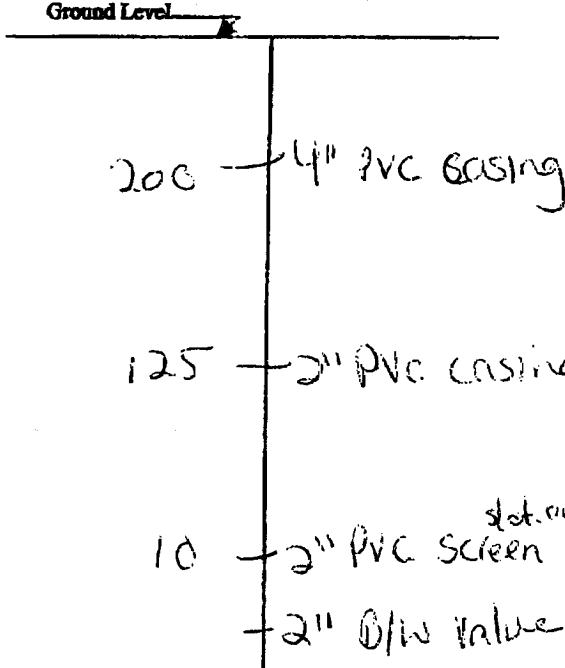

Description of formations encountered must be provided for all wells and boreholes, unless specifically exempted by regulations

Description of Formations Encountered	From (depth)	To (depth)
	Ground Level	
Top Soil	0	3
Sandy Red Clay	3	15
Coarse White Sand	15	35
Soft Red clay	35	280
Fine Water Sand	280	300
Coarse Water Sand	300	325

If more than one screen, show location of each on sketch

Sketch the property layout and include the following: 1) the well location; 2) any permanent structures on the property that may aid in locating the well; 3) any roads, power lines, or other items that may aid in locating the property and the well; 4) a north arrow.

Landowner Name: Ms. Niccuse

Form: OLWR-SWR-1A

I certify that the well/borehole was drilled, constructed, and completed in accordance with all applicable requirements of the Mississippi Department of Environmental Quality and the Mississippi Department of Health regulations, if applicable, and state laws.

Dwight Mason 0-209 2/10/06
Print Name of Responsible Licensee and License No. Date

Dwight Mason RECEIVED
Signature of Licensee

AUG 10 2006
BY: OLWR

Mason

STATE WELL REPORT

Part 2

Pump Installer's Completion Report
Mississippi Department of Environmental Quality
Office of Land and Water Resources
P.O. Box 10631
Jackson, MS 39289-0631
(601)961-5210
(601)354-6938 (fax)

County: Harrison
 Permit #: 0-209
 Driller: R. Mason
 Date completed: 7/10/06
Copy information from Hook on Part I

For Office Use Only:
 Aquifer: _____
 Well #: J-54342
 Elevation: _____

This part of the report must be completed by a licensed water well contractor or a licensed pump installer. A copy of Part 1 of the report must be attached and both parts filed with the Department at the above address within 30 days of well completion.

Well Owner Information	Well Location
Owner Name: <u>Ms. Neccaise</u>	Latitude: _____ Longitude: _____
Mailing Address: <u>118 Lower Bay Rd.</u>	Method of Lat/Long (check one): Conventional Survey _____
<u>Pass Christian, MS</u>	USGS quad _____ Hand-held GPS _____ Survey-grade GPS _____
City State Zip Code	<u>1/4 1/4 Sec 12 T 7 S R 13 W</u>
Telephone No. () _____	Distance Direction Nearest Town
	<u>12 Miles N of Pass Christian</u>

Pump Type Circle one	Power Type Circle one
Air Lift <input type="checkbox"/> Jet <input type="checkbox"/> Submersible <input checked="" type="checkbox"/>	Diesel Engine <input type="checkbox"/> Gasoline Engine <input type="checkbox"/> Natural Gas <input type="checkbox"/>
Bucket <input type="checkbox"/> Piston <input type="checkbox"/> Turbine <input type="checkbox"/>	Electric Motor <input checked="" type="checkbox"/> Hand <input type="checkbox"/> Tractor PTO <input type="checkbox"/>
Centrifugal <input type="checkbox"/> Rotary <input type="checkbox"/> Flowing Well <input type="checkbox"/>	Windmill <input type="checkbox"/> Other (specify): _____
Other (specify): _____	Horse Power Rating of Motor: <u>1</u>
Date Pump Installed: <u>7/10/06</u>	Setting Depth: <u>100</u> feet
Rated Pump Capacity: <u>15</u> Gallons Per Minute	Number of Stages: <u>14</u>

Pump Test Data	Method of Measuring Water Level Circle one
Date Well Tested: <u>7/10/06</u>	Air Line <input type="checkbox"/> Electric Measuring Line <input type="checkbox"/> Steel Tape <input type="checkbox"/>
Static Water Level (A): <u>85</u> Feet Below Land Surface	Other (specify): <u>Plumb bob</u>
Pumping Water Level (B): <u>85</u> Feet Below Land Surface	For flowing well, measured shut in head: <u>N/A</u> feet
Drawdown [(B) - (A)]: <u>0</u> Feet Below Land Surface	Well yielded <u>15</u> GPM with a drawdown of
Test Pumping Rate: <u>15</u> Gallons Per Minute	<u>0</u> feet after <u>4</u> hours of pumping
Duration of Pump Test (minimum 4 hours): <u>4</u> hours	

I HEREBY CERTIFY that the above statements are true to the best of my knowledge.

Dwight Mason 0-209 Dwight Mason
 Print Name of Pump Installer and License No. (if applicable) Signature of Pump Installer

RECEIVED
 AUG 10 2006
 BY: OLWR