		State Well Report	
I		-	For Office Use Only:
	County: Harrison	Part 1 – Driller's Log	for onnee ose omy.
		Mississippi Department of Environmental Quality	Aquifer:
	Permit #:	Office of Land and Water Resources	Well #: J-344
	Driller: Maluin Wagnon	P.O. Box 10631	well #:
		Jackson, MS 39289-0631	L. S. Elevation:
	Date drilling completed: <u>5717/07</u>	(601)961-5210	
	' /	(601)354-6938 (fax)	E-log #:

.

State Law requires that this report be prepared by the license holder responsible for the work and filed with the Department at the above address within 30 days of completion of drilling of the well or borehole.

Information on Well Owner	Well or Borehole Location				
(Landowner if borehole is not for a water well)	20 000 11 6 00 000 000 12 000				
Owner Name L. N. Construction	Latitude: <u>30 ° 28 ' 149</u> " Longitude: <u>089° 17 ' 79</u> P" 10 Method of Lat/Long (circle one): Conventional Survey,				
Mailing Address: <u>Cable Bridge Rd</u>					
U	USGS quade Hand-held GPS, Survey-grade GPS				
Gulfport MS 39503 City State Zip Code	Nor 1/4 NC 1/4 Sec_ Twn_ 75_ Rng 13				
City State Zip Code	Distance Direction Nearest Town				
Telephone No. (228) 861-2575	Miles of				
Telephone No. (228) 001 23 15					
Well / Bore	hole Data				
	2 241 - 1/5/."				
Date drilling started: $5/17/07$ Date drilling completed: $5/17/17/17/17/17/17/17/17/17/17/17/17/17/$					
Location of the source of any surface water used for drilling:					
Method of dosing and volume of Chlorine used in drilling and devel	lopment:				
Logs run (circle all applicable): No log run Electric Gamma Ray Density Sonic Neutron Other:					
Purpose of borehole (check one): Water Well Geotechnical/Geol	ogical Investigation Ground Source Heat Pump				
Seismic Survey Other (<i>describe</i>)					
If drilling is not related to water well construction, skip the remainder of this block					
Purpose of Well (check one): HomeIndustrial Public Supply	/ Irrigation Fish Culture Other:				
If a flowing well, method of flow regulation: Valve Other (describe)					
Static Water Level: <u>98</u> feet above or below (circle one) land surface Date measured: <u>5/17/07</u>					
Method of Measurement (circle one) steel tape electric tape air line other:					
Well depth: <u>340</u> Well grouted to a depth of <u>10</u> feet Type of grout (circle one) Neat Cement Bentonite Mix					
Casing length: <u>330</u> feet Casing diameter: <u>2</u> inches Type of casing: <u>PVC</u>					
Screen length: <u>10</u> feet Screen diameter: <u>2</u>	_inches Type of screen:				
Screen slot size:inches Setting depth: From	330 feet to 340 feet				
Type of completion (circle all applicable): Gravel packed Under	reamed Telescoped Open hole Natural Development				
Other (describe):					
Top of lap pipe or reduction in casing:feet. If ten	lescoped or more than one screen, describe on next page				
	Form: OI WR-SWR-14				

RECEIVED JUN 0 5 2007 BY: OLWR

344


The sketch below only required for water wells

If well telescopes, show depths on sketch. Ground Level_

Description of formations encountered must be provided for all wells and boreholes, unless specifically exempted by regulations

Description of Formations Encountered	From (depth)	
Clay	Ground Level	10
Sand	10	75
Clay	75	310
Sand	310	340
9.		

If more than one screen, show location of each on sketch

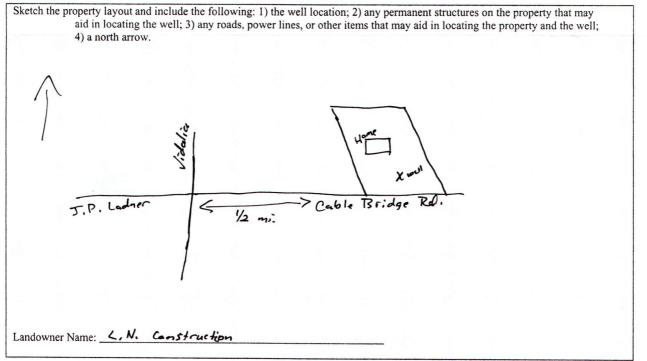

Form: OLWR-SWR-1A

I certify that the well/borehole was drilled, constructed, and completed in accordance with all applicable requirements of the Mississippi Department of Environmental Quality and the Mississippi Department of Health regulations, if applicable, and state laws.

Date

Malvin Wagnen 0-785 5/17/07 Mali Vagn

Print Name of Responsible Licensee and License No.

Signature of Licensee

RECEIVED JUN 0 5 2007 BY: OLWR

	STATE WELL REPORT
County: <u>Hancison</u> Permit #: Mi	Part 2 Pump Installer's Completion Report sissippi Department of Environmental Quality Aquifer:
Driller: Malvin Wagnon	Office of Land and Water Resources P.O. Box 10631
Date completed: $5/17/67$ Copy information from block on Part 1	Jackson, MS 39289-0631 (601)961-5210 (601)354-6938 (fax) Elevation:
This part of the report must be completed by a l	censed water well contractor or a licensed pump installer. A copy of Part 1 of the
Well Owner Information	the Department at the above address within 30 days of well completion. Well Location
Dwner Name: <u>L.N. Construction</u> Mailing Address: <u>Cable Brid</u> s	
	USGS quad, Hand-held GPS, Survey-grade GPS
City State	7503 Nr 1/4 NE 1/4 Sec 4 T 75 R 13m
	Distance Direction Nearest Town
Telephone No. (228) 861-2575	Miles of
Pump Type Circle one	Power Type Circle one
Air Lift Jet Sub	ersible Diesel Engine Gasoline Engine Natural Gas
Bucket Piston Turk	Electric Motor Hand Tractor PTO
	ing Well Windmill Other (specify):
Other (specify):	
Date Pump Installed: <u>5/17/07</u> Rated Pump Capacity:Gallo	
Pump Test Data	Method of Measuring Water Level
Date Well Tested:5/17/07	Circle one
Static Water Level (A): 98 Feet Below	
Pumping Water Level (B): <u>120</u> Feet Below	Land Surface
Drawdown [(B) – (A)]:Feet Below	Land Surface For flowing well, measured shut in head:feet
Test Pumping Rate:Gallo	
Duration of Pump Test (minimum 4 hours):	4hoursfeet afterhours of pumping
I HEREBY CERTIFY that the above statements a	a true to the best of my knowledge
THERE I CERTIFI I that the above statements a	c the to the best of my knowledge.
Malvin Wagnon 0-78	pplicable) Signature of Pump Installer

JUN 0 5 2007 BY: OLWR