	State Well Report
County: Harrison	Part 1 – Driller's Log
Permit #:	Mississippi Department of Environmental Quality Office of Land and Water Resources DO Day 10(21) Well #: J- 345
	Office of Land and Water Resources P.O. Box 10631
Driller: Malvin Wasnon	Jackson, MS 39289-0631 L. S. Elevation:
Date drilling completed: 5-21-07	(601)961-5210
	(601)354-6938 (fax) E-log #:
State I an requires that this repo	rt be prepared by the license holder responsible for the work and filed with the
Department at the above address	s within 30 days of completion of drilling of the well or borehole.
Information on Well	Owner Well or Borehole Location
(Landowner if borehole is not f	Latitude: 30 ° 27 ' 46/" Longitude: 09 ° 18 '81
Dwner Name Jenica Swi	Latitude: $30 \circ 27$, 461 , Longitude: $057 \circ 15$, 57 Latitude: $30 \circ 27$, 461 , Longitude: $057 \circ 15$, 57 Method of Lat/Long (circle one): Conventional Survey,
Dwner Name_Jenica_Swi Mailing Address:J, P. L	Method of Lat/Long (circle one): Conventional Survey,
Mailing Address:, J. F. L	USGS quad, Hand-held GPS Survey-grade GPS
	NW 1/4 NE 1/4 Sec 8 Twn 75 Rng 13
Pass Christian	MS 3957/ Kec Twn 13 Rng //
Pass Christian City Sta	
Telephone No. (228) 669 - 124	Miles of
	Well / Borehole Data
Date drilling started: 5-21-07 Date d	rilling completed: $5 - 21 - 0^{-2}$ Hole depth: 200 Hole diameter: 4^{-3} /4
Date unning started.	Thing completed.
Location of the source of any surface wat	er used for drilling:
Location of the source of any surface wat	
Location of the source of any surface wat Method of dosing and volume of Chlorin Logs run (circle all applicable). No log ru	er used for drilling:
Location of the source of any surface wat Method of dosing and volume of Chlorin Logs run (circle all applicable). No log ru	er used for drilling:
Location of the source of any surface wat Method of dosing and volume of Chlorin Logs run (circle all applicable): <u>No log ru</u> Name of organization running log(s):	er used for drilling:
Location of the source of any surface wat Method of dosing and volume of Chlorin Logs run (circle all applicable): <u>No log ru</u> Name of organization running log(s): Purpose of borehole (check one): Water W	er used for drilling:
Cocation of the source of any surface wat Method of dosing and volume of Chlorin Logs run (circle all applicable): <u>No log ru</u> Name of organization running log(s): Purpose of borehole (check one): Water W Seismic	er used for drilling:
Location of the source of any surface wat Method of dosing and volume of Chlorin Logs run (circle all applicable): <u>No log ru</u> Name of organization running log(s): Purpose of borehole (check one): Water W Seismic <u>If drilling is not related</u>	er used for drilling:
Location of the source of any surface wat Method of dosing and volume of Chlorin Logs run (circle all applicable): <u>No log ru</u> Name of organization running log(s): Purpose of borehole (check one): Water W Seismic <u>If drilling is not related</u>	er used for drilling:
Location of the source of any surface wat Method of dosing and volume of Chlorin Logs run (circle all applicable): <u>No log ru</u> Name of organization running log(s): Purpose of borehole (check one): Water W Seismic <i>If drilling is not related</i> Purpose of Well (check one): Home	er used for drilling:
Location of the source of any surface wat Method of dosing and volume of Chlorin Logs run (circle all applicable). <u>No log ru</u> Name of organization running log(s): Purpose of borehole (check one): Water W Seismic <i>If drilling is not related</i> Purpose of Well (check one): Home	er used for drilling:
Location of the source of any surface wat Method of dosing and volume of Chlorin Logs run (circle all applicable). <u>No log ru</u> Name of organization running log(s): Purpose of borehole (check one): Water W Seismic <i>If drilling is not related</i> Purpose of Well (check one): Home	er used for drilling:
Location of the source of any surface wat Method of dosing and volume of Chlorin Logs run (circle all applicable): <u>No log ru</u> Name of organization running log(s): Purpose of borehole (check one): Water W Seismic <i>If drilling is not related</i> Purpose of Well (check one): Home <u>1</u> If a flowing well, method of flow regulation Static Water Level: <u>25</u> feet a	er used for drilling:
Location of the source of any surface wat Method of dosing and volume of Chlorin Logs run (circle all applicable): <u>No log ru</u> Name of organization running log(s): Purpose of borehole (check one): Water W Seismic <i>If drilling is not related</i> Purpose of Well (check one): Home <u>I</u> If a flowing well, method of flow regulation Static Water Level: <u>25</u> feet a Method of Measurement (circle one) <u>S</u>	ter used for drilling:
Location of the source of any surface wat Method of dosing and volume of Chlorin Logs run (circle all applicable). No log ru Name of organization running log(s): Purpose of borehole (check one): Water W Seismic If drilling is not related Purpose of Well (check one): Home If a flowing well, method of flow regulation Static Water Level:feet a Method of Measurement (circle one) Well depth: Well grouted to a do	er used for drilling: ne used in drilling and development: In Electric Gamma Ray Density Sonic Neutron Other: Well Geotechnical/Geological Investigation Ground Source Heat Pump Survey Other (describe) d to water well construction, skip the remainder of this block Industrial Public Supply Irrigation Fish Culture Other: on: Valve Other (describe) bove or below (circle one) land surface Date measured: feel tape electric tape air line other: epth of <u>10</u> feet Type of grout (circle ore): Neat Cement Bentonite Mix
Location of the source of any surface wat Method of dosing and volume of Chlorin Logs run (circle all applicable). No log ru Name of organization running log(s): Purpose of borehole (check one): Water W Seismic If drilling is not related Purpose of Well (check one): Home If a flowing well, method of flow regulation Static Water Level:feet a Method of Measurement (circle one) Well depth: Well grouted to a do	ter used for drilling:
Location of the source of any surface wat Method of dosing and volume of Chlorin Logs run (circle all applicable). No log ru Name of organization running log(s): Purpose of borehole (check one): Water W Seismic If drilling is not related Purpose of Well (check one): Home If a flowing well, method of flow regulation Static Water Level: feet a Method of Measurement (circle one) Well depth: Well grouted to a du Casing length: feet Casi	er used for drilling: ne used in drilling and development: In Electric Gamma Ray Density Sonic Neutron Other: Well Geotechnical/Geological Investigation Ground Source Heat Pump Survey Other (describe) d to water well construction, skip the remainder of this block Industrial Public Supply Irrigation Fish Culture Other: on: Valve Other (describe) bove or below (circle one) land surface Date measured: feel tape electric tape air line other: epth of <u>10</u> feet Type of grout (circle ore): Neat Cement Bentonite Mix
Location of the source of any surface wat Method of dosing and volume of Chlorin Logs run (circle all applicable): <u>No log ru</u> Name of organization running log(s): Purpose of borchole (check one): Water W Seismic <i>If drilling is not related</i> Purpose of Well (check one): Home <u>for the seismic</u> If a flowing well, method of flow regulation Static Water Level: <u>25</u> feet a Method of Measurement (circle one) <u>seismic</u> Well depth: <u>200</u> Well grouted to a du Casing length: <u>190</u> feet Casi Screen length: <u>10</u> feet Screen	er used for drilling:
Location of the source of any surface wat Method of dosing and volume of Chlorin Logs run (circle all applicable): No log ru Name of organization running log(s): Purpose of borehole (check one): Water W Seismic If drilling is not related Purpose of Well (check one): Home If a flowing well, method of flow regulation Static Water Level:25 'feet a Method of Measurement (circle one)s Well depth:200 Well grouted to a du Casing length:190feet Casi Screen length:10feet Screen	er used for drilling:
Location of the source of any surface wat Method of dosing and volume of Chlorin Logs run (circle all applicable): No log run Logs run (circle all applicable): No log run Name of organization running log(s): Purpose of borehole (check one): Water W Seismic If drilling is not related Purpose of Well (check one): Home Purpose of Well (check one): Home If a flowing well, method of flow regulation Static Water Level: 25' feet a Method of Measurement (circle one) 5 Well depth: 200 Well grouted to a du 5 Casing length: 10 feet Case length: 10 feet Screen length: 0004 inches	er used for drilling:

.

1.1

Form: OLWR-SWR-1A RECEIVED JUN 0 5 2007 BY: OLWR


J-345

The sketch below only required for water wells

If well telescopes, show depths on sketch. Ground Level Description of formations encountered must be provided for all wells and boreholes, unless specifically exempted by regulations

Description of Formations Encountered	Ground Level	20
Sand	20	30
Clan	30	175
Sand	175	200

If more than one screen, show location of each on sketch

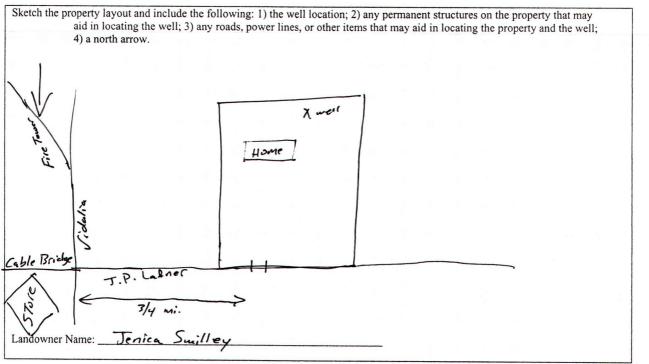

Form: OLWR-SWR-1A

Wagne

I certify that the well/borehole was drilled, constructed, and completed in accordance with all applicable requirements of the Mississippi Department of Environmental Quality and the Mississippi Department of Health regulations, if applicable, and state laws.

Date

MALVIN WAGNON 0-785 5-21-07

Print Name of Responsible Licensee and License No.

Signature of Licensee

JUN 0 5 2007 BY: OLWR

RECEIVED

STATE WELL REPORT				
Permit #: Pump Installer ³ Driller: Maluin Wagner Date completed: 5/21/07	Part 2 's Completion Report nt of Environmental Quality and Water Resources Box 10631 MS 39289-0631 961-5210 54-6938 (fax)			
report must be attached and both parts filed with the Department of	at the above address within 30 days of well completion.			
Well Owner Information	Well Location			
Owner Name: Jenica Swilley Mailing Address: J.P. Lodner Rd	Latitude: <u>30° 27.461</u> Longitude: <u>089° 18.815</u> <u>27</u> Method of Lat/Long (check one): Conventional Survey,			
	USGS quad, Hand-held GPS, Survey-grade GPS			
Pass Christian MS 3957/ City State Zip Code	Nw 1/ NE 1/ Sec 8 T_75 R_13w			
	Distance Direction Nearest Town			
Telephone No. (228) 669 - 1246	Miles of			
Pump Type Circle one	Power Type Circle one			
Air Lift Jet Submersible	Diesel Engine Gasoline Engine Natural Gas			
Bucket Piston Turbine	Electric Motor Hand Tractor PTO			
Centrifugal Rotary Flowing Well	Windmill Other (specify):			
Other (specify):	Horse Power Rating of Motor:/			
Date Pump Installed:	Setting Depth:feet			
Rated Pump Capacity:Gallons Per Minute	Number of Stages:			
Pump Test Data	Method of Measuring Water Level			
Date Well Tested: <u> 「ー 21ーのつ</u>	Circle one			
Static Water Level (A):Feet Below Land Surface	Air Line Electric Measuring Line Steel Tape			
Pumping Water Level (B): 6 Peet Below Land Surface	Other (specify):			
Drawdown [(B) – (A)]:Feet Below Land Surface	For flowing well, measured shut in head:feet			
Test Pumping Rate:Gallons Per Minute	Well yielded GPM with a drawdown of			
Duration of Pump Test (minimum 4 hours):24hours	feet afterhours of pumping			
I HEREBY CERTIFY that the above statements are true to the best of my knowledge. Print Name of Pump Installer and License No. (if applicable) Signature of Pump Installer				

.

. .

Form: OLWR-SWR-0B5 2007 BY: OLWR