

State Well Report

Part 1

Mississippi Department of Environmental Quality
 Office of Land and Water Resources
 P.O. Box 10631
 Jackson, MS 39289-0631
 (601)961-5210
 (601)354-6938 (fax)

For Office Use Only:

Aquifer: _____
 Well #: J-361
 L. S. Elevation: _____
 E-log #: _____

County: Harrison
 Permit #: 0239
 Driller: McGill Pump & Well
 Date drilling completed: 11/29/07

State Law requires that this report be prepared by the driller in detail and filed with the Department within 30 days of completion of drilling of the well.

Well Owner Information	Well Location
Owner Name: <u>Craig Brown</u>	Latitude: _____ Longitude: _____
Mailing Address: <u>Sablewood Sub Div.</u> <u>MENGE AVE.</u> <u>P.C. MS.</u>	Method of Lat/Long (circle one): <input type="radio"/> Conventional Survey, <input type="radio"/> USGS quad, <input type="radio"/> Hand-held GPS, <input type="radio"/> Survey-grade GPS
City: _____ State: _____ Zip Code: _____	<u>1/4</u> <u>1/4</u> Sec <u>36</u> Twn <u>7S</u> Rng <u>13W</u>
Telephone No: <u>228, 669-7072</u>	Distance _____ Direction _____ Nearest Town _____ <u>2</u> Miles <u>N</u> of <u>P.C.</u>

Well Data

Purpose of Well (circle one) Home Industrial Public Supply Irrigation Fish Culture Other: _____

Date well drilling started: 11/28/07 Date well drilling completed: 11/29/07

If flowing, method of flow regulation: Valve _____ Other (describe) _____

Static Water Level: 30 feet above or below (circle one) land surface Date measured: 11/29/07

Method of Measurement (circle one) steel tape electric tape air line other: _____

Hole depth: 640 Well depth: 640 Well grouted to a depth of 10 feet

Type of grout (circle one): Cement Bentonite Mix

Casing length: 620 feet Casing diameter: 2 inches Type of casing: PVC

Screen length: 20 feet Screen diameter: 2 inches Type of screen: PVC

Screen slot size: .0506 inches Setting depth: From 620 feet to 640 feet

Type of completion (circle all applicable): Gravel packed Underreamed Telescoped Open hole Natural Development

Other (describe): _____

Top of lap pipe or reduction in casing: _____ feet. If telescoped or more than one screen, describe on back of page

Logs run (circle all applicable): No log run Electric Gamma Ray Density Sonic Neutron Other: _____

Name of organization running log(s): _____

I certify that the well was drilled, constructed, and completed in accordance with all applicable requirements of the Mississippi Department of Environmental Quality and/or the Mississippi Department of Health regulations and state laws.

McGill Pump & Well 0239
 Print Name of Water Well Contractor and License No.

Michael McGill Sr.
 Signature of Water Well Contractor

RECEIVED
 DEC 19 2007
 BY: OLWR

J-361

If well telescopes please sketch below and show depths.


Ground Level

Blank area for well telescopes sketch.

Description of Formations Encountered	From	To
Sand (blue)	0	100
MUD (blue)	100	300
SAND (blue)	300	340
MUD (blue)	340	580
SAND (blue)	580	640

If more than one screen, show location of each on sketch

Sketch the property layout and include the following: 1) the well location; 2) any permanent structures on the property that may aid in locating the well; 3) any roads, power lines, or other items that may aid in locating the property and the well; 4) indicate direction.

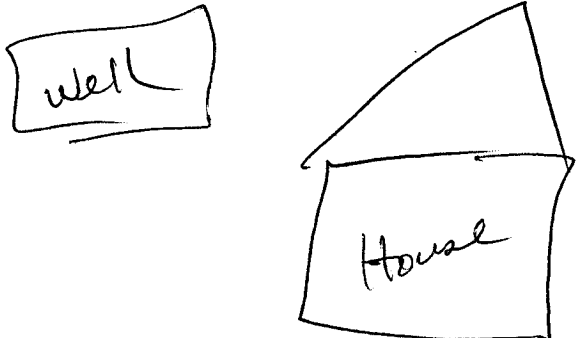

owner Name: Craig Brown (Lakeview)

RECEIVED
 DEC 13 2007
 BY OLWR

STATE WELL REPORT

Part 2

Pump Installer's Completion Report
 Mississippi Department of Environmental Quality
 Office of Land and Water Resources
 P.O. Box 10631
 Jackson, MS 39289-0631
 (601)961-5210
 (601)354-6938 (fax)

For Office Use Only:

Aquifer: _____

Well #: J-361

Elevation: _____

County: Harrison
 Permit #: 0239
 Well Name: McGill Pump Well
 Date completed: 11/29/07

This report should be prepared by the pump installer in detail and filed with the Department within 30 days of the installation of pump.

Well Owner Information	Well Location
Owner Name: <u>Craig Brown</u>	Latitude: _____ Longitude: _____
Well Address: <u>Subsloard Sub-Div</u> <u>Off Meigs Ave.</u> <u>P.C. MS.</u>	Method of Lat/Long (circle one): Conventional Survey, USGS quad, Hand-held GPS, Survey-grade GPS
City _____ State _____ Zip Code _____	<u>1/4</u> _____ <u>1/4</u> Sec <u>36</u> Twn <u>7S</u> Rng <u>B W</u>
Phone No. <u>228 669-2072</u>	Distance _____ Direction _____ Nearest Town _____
	<u>2</u> Miles <u>N</u> of <u>P.C.</u>

Pump Type Circle one	Power Type Circle one
Lift <input checked="" type="radio"/> Jet	Diesel Engine <input type="radio"/> Gasoline Engine <input type="radio"/> Natural Gas <input type="radio"/>
Centrifugal <input type="radio"/> Piston <input type="radio"/> Turbine <input type="radio"/>	<input checked="" type="radio"/> Electric Motor <input type="radio"/> Hand <input type="radio"/> Tractor PTO <input type="radio"/>
Vertical <input type="radio"/> Rotary <input type="radio"/> Flowing Well <input type="radio"/>	Windmill <input type="radio"/> Other (specify): _____
Other (specify): _____	Horse Power Rating of Motor: <u>1 1/2</u>
Date Pump Installed: <u>11/29/07</u>	Setting Depth: <u>60</u> feet
Rated Pump Capacity: <u>12</u> Gallons Per Minute	Number of Stages: <u>3</u>

Pump Test Data	Method of Measuring Water Level Circle one
Date Well Tested: <u>11/29/07</u>	Air Line <input type="radio"/> Electric Measuring Line <input type="radio"/> <input checked="" type="radio"/> Steel Tape
Static Water Level (A): <u>30</u> Feet Below Land Surface	Other (specify): _____
Pumping Water Level (B): <u>60</u> Feet Below Land Surface	For flowing well, measured shut in head: _____ feet
Drawdown [(B) - (A)]: <u>15</u> Feet Below Land Surface	Well yielded <u>12</u> GPM with a drawdown of
Pumping Rate: <u>12</u> Gallons Per Minute	<u>15</u> feet after <u>4</u> hours of pumping
Duration of Pump Test (minimum 4 hours): <u>4</u> hours	

RECEIVED
DEC 19 2007

I HEREBY CERTIFY that the above statements are true to the best of my knowledge.

BY: **OLWR**

McGill Pump & Well 0239

Michael P. McNeill