

County: HARRISON
 Permit #: _____
 Driller: SCHULTZ
 Date drilling completed: 6/15/07

State Well Report
Part 1 - Driller's Log

Mississippi Department of Environmental Quality
 Office of Land and Water Resources
 P.O. Box 10631
 Jackson, MS 39289-0631
 (601)961-5210
 (601)354-6938 (fax)

For Office Use Only:
 Aquifer: _____
 Well #: J-367
 L. S. Elevation: _____
 E-log #: _____

State Law requires that this report be prepared by the license holder responsible for the work and filed with the Department at the above address within 30 days of completion of drilling of the well or borehole.

<p>Information on Well Owner <i>(Landowner if borehole is not for a water well)</i></p> <p>Owner Name: <u>J. ROUSE</u> Mailing Address: <u>14306</u> <u>ALCIDE LIZANA RD.</u> <u>GULFPORT MS. 39502</u> City State Zip Code Telephone No. () _____</p>	<p>Well or Borehole Location</p> <p>Latitude: <u>30.29.256</u> Longitude: <u>89.14.653</u> Method of Lat/Long (circle one): <u>Hand-held GPS</u>, Conventional Survey, USGS quad, Survey-grade GPS <u>SE 1/4 SE 1/4 Sec 25 Twn 7S Rng 13W</u> Distance Direction Nearest Town <u>0</u> Miles <u>N</u> of <u>Long Beach</u></p>
----------------------------------------------------------------------------------------------------------------------------------------------------------------------------------------------------------------------------------------------------------------------------------------------------------------	-----------------------------------------------------------------------------------------------------------------------------------------------------------------------------------------------------------------------------------------------------------------------------------------------------------------------------------------------------------------------

Well / Borehole Data


Date drilling started: 7/1/07 Date drilling completed: 2/1/07 Hole depth: 300 Hole diameter: 8"
 Location of the source of any surface water used for drilling: SIDY LAKE
 Method of dosing and volume of Chlorine used in drilling and development: 1.5 ATZ
 Logs run (circle all applicable): No log run Electric Gamma Ray Density Sonic Neutron Other: _____
 Name of organization running log(s): _____
 Purpose of borehole (check one): Water Well Geotechnical/Geological Investigation _____ Ground Source Heat Pump _____
 Seismic Survey _____ Other (describe) _____
If drilling is not related to water well construction, skip the remainder of this block
 Purpose of Well (check one): Home Industrial _____ Public Supply _____ Irrigation _____ Fish Culture _____ Other: _____
 If a flowing well, method of flow regulation: Valve _____ Other (describe) _____
 Static Water Level: 70' feet above or below (circle one) land surface Date measured: 7/2/07
 Method of Measurement (circle one) steel tape electric tape air line other: _____
 Well depth: 300 Well grouted to a depth of 10 feet Type of grout (circle one): Neat Cement Bentonite Mix
 Casing length: 280 feet Casing diameter: 4" inches Type of casing: PVC
 Screen length: 20 feet Screen diameter: 2" inches Type of screen: PVC
 Screen slot size: 006 inches Setting depth: From 280 feet to 300 feet
 Type of completion (circle all applicable): Gravel packed Underreamed Telescoped Open hole Natural Development
 Other (describe): _____
 Top of lap pipe or reduction in casing: _____ feet. *If telescoped or more than one screen, describe on next page*

J-367

The sketch below only required for water wells

Description of formations encountered must be provided for all wells and boreholes, unless specifically exempted by regulations

If well telescopes, show depths on sketch.

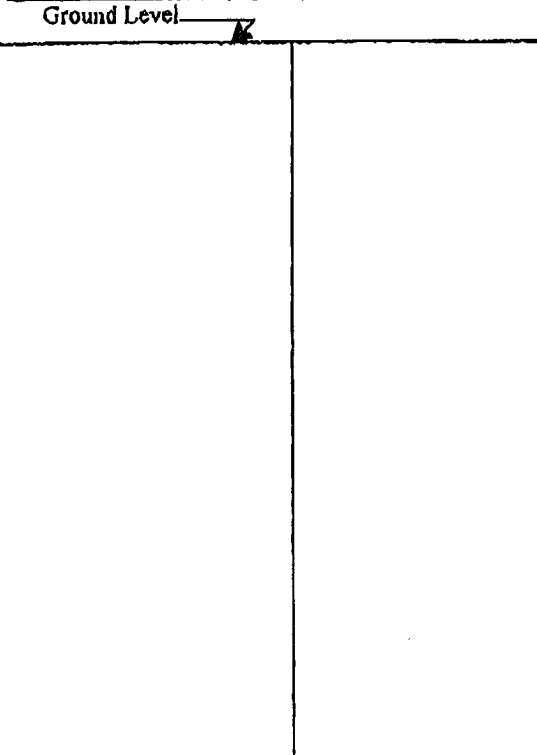

Description of Formations Encountered	From (depth)	To (depth)
	Ground Level	
CLAY		
	0	100'
SAND	100	120
CLAY		
SAND		80'

If more than one screen, show location of each on sketch

Sketch the property layout and include the following: 1) the well location; 2) any permanent structures on the property that may aid in locating the well; 3) any roads, power lines, or other items that may aid in locating the property and the well; 4) a north arrow.

Landowner Name: Mike J. ROUSE

Form: OLWR-SWR-1A

I certify that the well/borehole was drilled, constructed, and completed in accordance with all applicable requirements of the Mississippi Department of Environmental Quality and the Mississippi Department of Health regulations, if applicable, and state laws.

MIKE W. SCHULTZ 8/2/07 [Signature]