

30 25 17
891923

Harrison

MISSISSIPPI DEPARTMENT OF ENVIRONMENTAL QUALITY

Office of Land and Water Resources

P. O. Box 10631
Jackson, MS 39289-0631
WATER WELL DRILLERS LOG

COUNTY WELL LOCATED
Harrison

WELL NUMBER
J 382

CODED

DATE WELL COMPLETED
1-13-04

PERMIT NUMBER

NAME OF DRILLING FIRM
Basal Drilling
Service Co

NAME & MAILING ADDRESS OF LANDOWNER
Brett Graves

8888 Smith + Dubrissen

Latitude:

Longitude:

WELL LOCATION SEC TOWNSHIP RANGE
20 7 N 13 W

DISTANCE DIRECTION NEAREST TOWN
5 Miles N of North

OTHER LANDMARK

WELL PURPOSE: Home, Irrigation, Municipal, Industrial, Fish Pond, etc.
Home

PUMP DATA

PUMP TYPE (Circle One):
Submersible, Turbine, Jet Flowing Well,
Other (Describe) _____

POWER TYPE (Circle One):
Electric Tractor, Diesel, Gasoline, Butane,
Other (Describe) _____ H/P _____

DESCRIPTION OF FORMATIONS ENCOUNTERED	FROM	TO
<u>Top soil</u>	<u>1</u>	<u>5</u>
<u>Sugar Sand</u>	<u>5</u>	<u>23</u>
<u>Red clay</u>	<u>23</u>	<u>140</u>
<u>Blue clay</u>	<u>140</u>	<u>180</u>
<u>pine sand</u>	<u>180</u>	<u>190</u>
<u>Coarse Sand</u>	<u>190</u>	<u>200</u>

WELL DATA

Well Depth Casing Diameter (In.) Casing Length (Ft.)
200 2 190

Type of Casing Hole Depth Depth to Static Water Level
PVC 200 40

TYPE OF COMPLETION: (Circle One or More):
Gravel Packed, Underreamed, Telescoped,
Natural Development, Open Hole, Other
(Describe) _____

WELL GROUTED TO A DEPTH OF 15 FEET
Type Grout (circle one): Cement, Bentonite, or Mix

SCREEN DATA

Diameter - Inches Length - Feet Slot Size - Inches
2 10 .006

Screen Type Depth to Bottom - Feet
PVC 200

RECEIVED
FEB 09 2004
BY: OLWR

Top of Lap Pipe or Reduction in Casing

FEET IF TELESCOPED OR MORE THAN ONE SCREEN: USE BACK PAGE

I certify that the well was drilled, constructed and completed in accordance with all applicable Requirements of the Mississippi Department of Environmental Quality and/or the Mississippi Department of Health regulations and state laws.


Deed Min 0-209
Signature of Licensed Driller and License No.

2-4-03
Date

Additional Information Required On Back

If well telescopes please sketch and show depths.

GROUND LEVEL

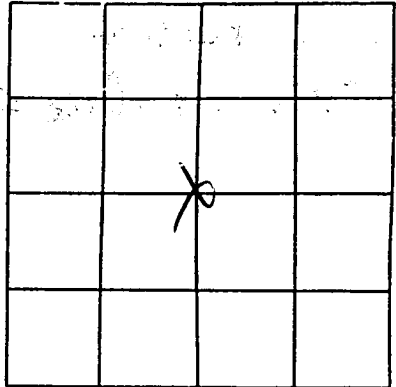

SECTION _____

Please indicate well location X.

Pump Capacity (GPM)	No. of Stages	Setting Depth
15	2	60 FT.

PUMP TEST

Well yielded 15 GPM with a drawdown of 0 ft. after 2 hours of pumping

LOG DATA

TYPE OF LOG RUN (Circle One): No Log Run, Electric, Gamma Ray, Density, Sonic, Neutron, Other (Describe) _____

Name of Organization Running Log _____

GEOLOGIC DATA (Office Use Only)

Surface Elev.	Geologic Unit	Unit Thickness	Depth to Top
Subs. SWL	Date	Analysis	Aquifer Test

Driller's Remarks

If more than one screen, show location of each on sketch.