

**State Well Report
Part 1 - Driller's Log**

Mississippi Department of Environmental Quality
Office of Land and Water Resources
P.O. Box 10631
Jackson, MS 39289-0631
(601)961-5210
(601)354-6938 (fax)

County: Harrison
Permit #: 0239
Driller: Megix Pump & Well
Date drilling completed: 3-07-12

For Office Use Only:
Aquifer: _____
Well #: J392
L. S. Elevation: _____
E-log #: _____

State Law requires that this report be prepared by the license holder responsible for the work and filed with the Department at the above address within 30 days of completion of drilling of the well or borehole.

Information on Well Owner (Landowner if borehole is not for a water well)	Well or Borehole Location
Owner Name: <u>GARLON DONES</u>	Latitude: <u>30° 23' 31"</u> Longitude: <u>89° 16' 19"</u>
Mailing Address: <u>LOT 19</u> <u>Magnolia Walk</u> <u>P.O. Ms. 39571</u> City State Zip Code	Method of Lat/Long (circle one): Conventional Survey, USGS quad, Hand-held GPS, Survey-grade GPS
Telephone No. <u>(228) 206-6223</u>	<u>1R 1/4 1R 1/4 Sec 39</u> Twn <u>7S</u> Rng <u>13W</u> Distance Direction Nearest Town <u>10</u> Miles <u>EAST</u> of <u>GPT</u>

Well / Borehole Data

Date drilling started: 3/5/12 Date drilling completed: 3/7/12 Hole depth: 560' Hole diameter: 4x2

Location of the source of any surface water used for drilling: Water Well

Method of dosing and volume of Chlorine used in drilling and development: _____

Logs run (circle all applicable): No log run Electric Gamma Ray Density Sonic Neutron Other: _____

Name of organization running log(s): _____

Purpose of borehole (check one): Water Well Geotechnical/Geological Investigation _____ Ground Source Heat Pump _____

Seismic Survey _____ Other (describe) _____

If drilling is not related to water well construction, skip the remainder of this block

Purpose of Well (check one): Home Industrial _____ Public Supply _____ Irrigation _____ Fish Culture _____ Other: _____

If a flowing well, method of flow regulation: Valve Backwash Other (describe) _____

Static Water Level: 20' feet above or below (circle one) land surface Date measured: _____

Method of Measurement (circle one) steel tape electric tape air line other: _____

Well depth: 560 Well grouted to a depth of 10 feet Type of grout (circle one): Neat Cement Bentonite Mix

Casing length: 540 feet Casing diameter: 4x2 inches Type of casing: PVC

Screen length: 20 feet Screen diameter: 2" inches Type of screen: PVC

Screen slot size: .0006 inches Setting depth: From 540 feet to 560 feet

Type of completion (circle all applicable): Gravel packed Underreamed Telescoped Open hole Natural Development


Other (describe): _____

Top of lap pipe or reduction in casing: 200' feet. *If telescoped or more than one screen, describe on next page*

RECEIVED
Form: OLWR-SWR-1A
NOV 01 2012
BY: OLWR

If well telescopes please sketch below and show depths.

Ground Level

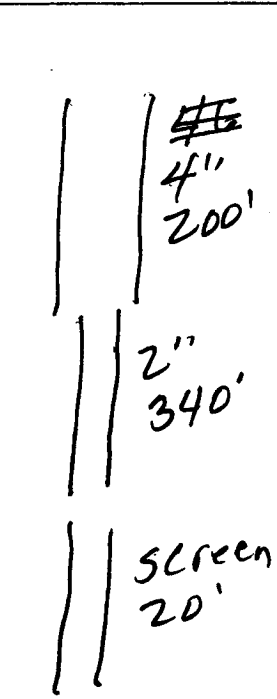

Description of Formations Encountered	From	To
Mud	0	160
Sand	160	170
Mud	170	350
Sand	350	370
Mud	370	400
Sand	400	420
Mud	420	500
Sand	500	560

If more than one screen, show location of each on sketch

Sketch the property layout and include the following: 1) the well location; 2) any permanent structures on the property that may aid in locating the well; 3) any roads, power lines, or other items that may aid in locating the property and the well; 4) indicate direction.

Landowner Name: Garlon Homes Lot. 19

Michael White Jr.
 Signature of Water Well Contractor

RECEIVED
 NOV 6 1 2012
 BY: OLIVER

STATE WELL REPORT

Part 2

Pump Installer's Completion Report
 Mississippi Department of Environmental Quality
 Office of Land and Water Resources
 P.O. Box 10631
 Jackson, MS 39289-0631
 (601)961-5210
 (601)354-6938 (fax)

For Office Use Only:

Acquifer: _____
 Well #: J392
 Elevation: _____

County: Harrison
 Permit #: 0239
 Driller: McGill Pump & Well
 Date completed: 3-7-12
Copy information from block on Part 1

This part of the report must be completed by a licensed water well contractor or a licensed pump installer. A copy of Part 1 of the report must be attached and both parts filed with the Department at the above address within 30 days of well completion.

Well Owner Information	Well Location
Owner Name: <u>GARLEN HOMES</u>	Latitude: _____ Longitude: _____
Mailing Address: <u>LOT 19</u> <u>Magnolia Walk</u> <u>P.C. Ms. 39571</u> City State Zip Code	Method of Lat/Long (check one): Conventional Survey _____ USGS quad _____, Hand-held GPS _____, Survey-grade GPS _____ <u>1R</u> ¼ <u>1R</u> ¼ Sec <u>239</u> T <u>7S</u> R <u>13W</u>
Telephone No. <u>(228) 206-6223</u>	Distance Direction <u>35</u> Nearest Town <u>10</u> Miles <u>EAST</u> of <u>GPT.</u>

Pump Type Circle one	Power Type Circle one
Air Lift Jet <input type="radio"/> <input checked="" type="radio"/> Submersible	Diesel Engine Gasoline Engine Natural Gas
Bucket Piston Turbine	<input checked="" type="radio"/> Electric Motor Hand Tractor PTO
Centrifugal Rotary Flowing Well	Windmill Other (specify): _____
Other (specify): _____	Horse Power Rating of Motor: <u>1</u>
Date Pump Installed: <u>3/7/12</u>	Setting Depth: <u>120</u> feet
Rated Pump Capacity: <u>18</u> Gallons Per Minute	Number of Stages: <u>8</u>

Pump Test Data	Method of Measuring Water Level Circle one
Date Well Tested: <u>3/7/12</u>	Air Line Electric Measuring Line <input checked="" type="radio"/> Steel Tape
Static Water Level (A): <u>70</u> Feet Below Land Surface	Other (specify): _____
Pumping Water Level (B): <u>120</u> Feet Below Land Surface	For flowing well, measured shut in head: _____ feet
Drawdown [(B) - (A)]: <u>15</u> Feet Below Land Surface	Well yielded <u>18</u> GPM with a drawdown of
Test Pumping Rate: <u>18</u> Gallons Per Minute	<u>15</u> feet after <u>15</u> hours of pumping
Duration of Pump Test (minimum 4 hours): <u>12</u> hours	

I HEREBY CERTIFY that the above statements are true to the best of my knowledge.

Michael P. McGill Sr. 0239
 Print Name of Pump Installer and License No. (if applicable)

Michael McGill Sr.
 Signature of Pump Installer

RECEIVED
 NOV 6 1 2012

Form: OLWR-SWR-1B

BY: OLWR