

County: HARRISON
 Permit #: _____
 Driller: M. SCHULTZ
 Date drilling completed: 4/21/13

State Well Report
Part 1 - Driller's Log
 Mississippi Department of Environmental Quality
 Office of Land and Water Resources
 P.O. Box 2309
 Jackson, MS 39225
 (601)961- 5210
 (601)961- 5228 (fax)

For Office Use Only:
 Aquifer: _____
 Well #: J401
 L. S. Elevation: _____
 E-log #: _____

State Law requires that this report be prepared by the license holder responsible for the work and filed with the Department at the above address within 30 days of completion of drilling of the well or borehole.

Information on Well Owner <i>(Landowner if borehole is not for a water well)</i>	Well or Borehole Location
Owner Name: <u>DOT GARCIA</u>	Latitude: <u>30° 27.44'</u> Longitude: <u>89° 19.20'</u>
Mailing Address: <u>S9123</u> <u>WOOD LAKE RD</u> <u>PASS CHRISTIAN, MS 39524</u>	Method of Lat/Long (circle one): Conventional Survey, USGS quad, <u>Hand-held GPS</u> , Survey-grade GPS
City: _____ State: _____ Zip Code: _____	NW ¼ SW ¼ Sec <u>5</u> Twn <u>7S</u> Rng <u>13W</u>
Telephone No. () _____	Distance: <u>2</u> Miles Direction: <u>SW</u> of Nearest Town: <u>WELLS</u>

Well / Borehole Data

Date drilling started: 4/21 Date drilling completed: 4/21/13 Hole depth: 280 Hole diameter: 4"

Location of the source of any surface water used for drilling: N/A

Method of dosing and volume of Chlorine used in drilling and development: 1 1/2 pints

Logs run (circle all applicable): No log run Electric Gamma Ray Density Sonic Neutron Other: _____

Name of organization running log(s): _____

Purpose of borehole (check one): Water Well Geotechnical/Geological Investigation _____ Ground Source Heat Pump _____

Seismic Survey _____ Other (describe) _____

If drilling is not related to water well construction, skip the remainder of this block

Purpose of Well (check one): Home Industrial _____ Public Supply _____ Irrigation _____ Fish Culture _____ Other: _____

If a flowing well, method of flow regulation: Valve _____ Other (describe) _____

Static Water Level: 35' feet above or below (circle one) land surface Date measured: 3/21/13

Method of Measurement (circle one) steel tape electric tape air line other: _____

Well depth: 280 Well grouted to a depth of 10 feet Type of grout (circle one): Neat Cement Bentonite Mix

Casing length: 270 feet Casing diameter: 2 inches Type of casing: PVC

Screen length: 10 feet Screen diameter: 2 inches Type of screen: PVC

Screen slot size: 006 inches Setting depth: From 270 feet to 280 feet

Type of completion (circle all applicable): Gravel packed Underreamed Telescoped Open-hole Natural Development _____


Other (describe): _____

Top of lap pipe or reduction in casing: N/A feet. *If telescoped or more than one screen, describe on next page*

Form: OLWR-SWR-1A (04/08)
RECEIVED
 MAY 31 2013
 BY: OLWR

The sketch below only required for water wells

If well telescopes, show depths on sketch.

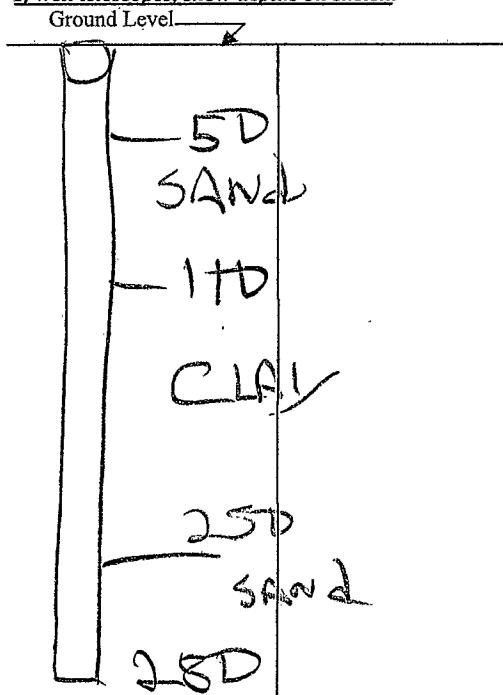


Description of formations encountered must be provided for all wells and boreholes, unless specifically exempted by regulations

Description of Formations Encountered	From (depth)	To (depth)
	Ground Level	

If more than one screen, show location of each on sketch

Sketch the property layout and include the following: 1) the well location; 2) any permanent structures on the property that may aid in locating the well; 3) any roads, power lines, or other items that may aid in locating the property and the well; 4) a north arrow.

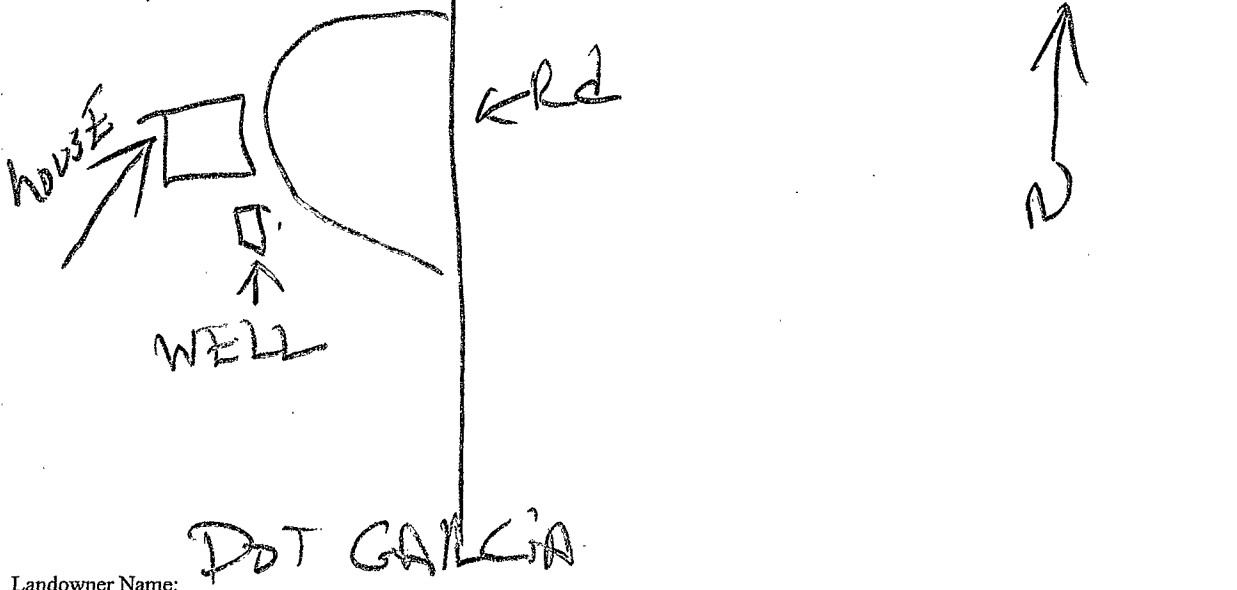

Landowner Name: DOT GARCIA

Form: OLWR-SWR-1A (04/08)

I certify that the well/borehole was drilled, constructed, and completed in accordance with all applicable requirements of the Mississippi Department of Environmental Quality and the Mississippi Department of Health regulations, if applicable, and state laws.

MIKE SCHULTZ
Print Name of Responsible Licensee and License No.

4/28/13
Date

[Signature]
Signature of Licensee

RECEIVED
MAY 31 2013
BY: OLWR