

STATE WELL REPORT

Part 1

Driller's Log

Mississippi Department of Environmental Quality
Office of Land and Water Resources
P.O. Box 2309
Jackson, MS 39225-2309
(601)961-5210
(601)360-0535 (fax)

County: <u>Harrison</u>
Permit #: <u>0239</u>
Driller: <u>Mc Gill Pump & Well</u>
Date drilling completed: <u>1-3-17</u>

For Office Use Only:	
Well #: <u>J424</u>	Aquifer: _____
E-Log #: _____	_____

State Law requires that this report be prepared by the license holder responsible for the work and filed with the Department at the above address within 30 days of completion of drilling of the well or borehole.

Well Owner Information <small>(Landowner if borehole is not for a water well)</small>	Well or Borehole Location
Owner Name: <u>Pat Chapman</u>	Latitude: <u>30° 28' 12.15" N</u> Longitude: <u>89° 18' 37.65" W</u>
Mailing Address: <u>12574 acy Ladner Rd</u>	Method of Lat/Long (check one): Conventional Survey _____, USGS quad _____, Hand-held GPS <input checked="" type="checkbox"/> , Survey-grade GPS _____
<u>Pass Christian MS 39571</u> City State Zip Code	<u>NE 1/4 NE 1/4, Sec 815 T 75 R 13W</u>
Telephone No. <u>(228) 383-8320</u>	<u>7.6</u> Miles <u>north</u> of <u>DeLisle</u> (Distance) (Direction) (Nearest Town)

Well / Borehole Data
Date drilling started: <u>1-2-17</u> Date drilling completed: <u>1-3-17</u> Hole depth: <u>520</u> Hole diameter: <u>4x2</u>
Location of the source of any surface water used for drilling: <u>well water</u>
Method of dosing and volume of Chlorine used in drilling and development: <u>NA</u>
Logs run (circle all applicable): <input checked="" type="checkbox"/> No log run Electric Gamma Ray Density Sonic Neutron Other: _____
Name of organization running log(s): <u>NA</u>
Purpose of borehole (circle one): <input checked="" type="checkbox"/> Water Well Geotechnical/Geological Investigation Ground Source Heat Pump Seismic Survey Other (describe) _____
<i>If drilling is not related to water well construction, skip the remainder of this block</i>

Purpose of Well (circle all applicable): <input checked="" type="checkbox"/> Home Industrial Public Supply Irrigation Fish Culture
Other (describe): _____
If a flowing well, method of flow regulation: Valve _____ Other (describe) <u>Back Wash Valve</u>
Static Water Level: <u>110</u> feet [above or <input checked="" type="checkbox"/> below] land surface Date measured: <u>1-5-17</u> (circle one)
Method of measurement (circle one): <input checked="" type="checkbox"/> Steel tape Electric tape Air line Other (describe): _____
Well depth: <u>520</u> Well grouted to a depth of: <u>10</u> feet Type of grout (circle one): <input checked="" type="checkbox"/> Neat Cement Bentonite Mix
Casing length: <u>500</u> feet Casing diameter: <u>4x2</u> inches Type of casing: <u>PVC</u>
Screen length: <u>20</u> feet Screen diameter: <u>2</u> inches Type of screen: <u>PVC</u>
Screen slot size: <u>1006</u> inches Setting depth: From <u>500</u> feet to <u>520</u> feet
Type of completion (circle all applicable): Gravel packed Underreamed Open hole <input checked="" type="checkbox"/> Natural Development
Other (describe): _____
Top of lap pipe or reduction in casing: <u>200</u> feet
<i>If telescoped or more than one screen, describe on next page</i>

RECEIVED

JAN 20 2017
Form: OLWR-SWR-1A (4/13)

BY OLWR

1000

1000

1000

1000

STATE WELL REPORT

Part 2

Pump Installer's Completion Report
 Mississippi Department of Environmental Quality
 Well Office of Land and Water Resources
 P.O. Box 2309
 Jackson, MS 39225-2309
 (601)961-5210
 (601) 360-0535 (fax)

County: HARRISON
 Permit #: 0239
 Driller: MLC Bill Pump & Well
 Date completed: 0239
Copy information from block on Part 1

For Office Use Only:

Well #: J424
 Aquifer: _____

This part of the report must be completed by a licensed water well contractor or a licensed pump installer. A copy of Part 1 of the report must be attached and both parts filed with the Department at the above address within 30 days of well completion.

Well Owner Information	Well Location
Owner Name: <u>pat chapman</u>	Latitude: <u>30° 28' 12.15" N</u> Longitude: <u>89° 18' 37.65" W</u>
Mailing Address: <u>12574 act Ladner Rd</u>	Method of Lat/Long (check one): Conventional Survey _____, Hand-held GPS <input checked="" type="checkbox"/> , Survey-grade GPS _____
<u>Pass christian ms 39571</u> City State Zip Code	USGS quad _____, NE $\frac{1}{4}$ NE $\frac{1}{4}$, Sec. <u>B5 T7 S13 R13W</u>
Telephone No. <u>(228) 383-8320</u>	<u>7.6</u> Miles <u>north</u> of <u>De Lisle</u> (Distance) (Direction) (Nearest Town)

Pump Type (circle one)

Submersible Turbine Air Lift Centrifugal Flowing Well Jet Piston Rotary Other (describe): _____

Date Pump Installed: 1-5-17 Rated Pump Capacity: 25 Gallons Per Minute

Is This Pump (circle one): New Repaired Replacement

Power Type (circle one)

Electric Diesel Gasoline Natural Gas Tractor PTO Windmill Other (describe): _____

Horse Power Rating of Motor: 1 1/2 Setting Depth: 150 feet Number of Stages: 10

Pump Test Data for Non Flowing Well

Date Well Tested: 1-3-17 Duration of Pump Test (minimum 4 hours): 4 hours

Static Water Level (A): 110 Feet Below Land Surface Pumping Water Level (B): 150 Feet Below Land Surface

Drawdown [(B) - (A)]: 10 Feet Below Land Surface Test Pumping Rate: 40 Gallons Per Minute

Method of measurement (circle one): Steel tape Electric tape Air line Other (describe): _____

Pump Test Data for Flowing Well N/A

Measured shut in head: _____ feet

Well yielded _____ GPM with a drawdown of _____ feet after _____ hours of pumping

Meter Installation N/A

Meter Manufacturer: _____ Meter Serial Number: _____

Meter Model Number/Name: _____ Type of Meter: _____

Totalizer Register Unit and Multiplier Factor (AF x .001, gal x 1000, etc): _____

Installation Date: _____ Meter installed by: _____

Is This Meter (circle one): New Repaired Replacement


Important: By submitting the above information you are certifying that this meter was installed to manufacturer standards. For agricultural wells, a list of approved meters is on the MDEQ website.

I HEREBY CERTIFY that the above statements are true to the best of my knowledge.

Michael McNeil License No. 0239 Date 1/19/17 Signature of Pump Installer _____

RECEIVED

BY OLWR

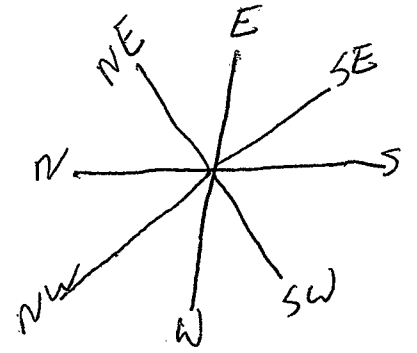

Wyatt
Earl

Carson Rd

Ray Ladner

house

house
trailer

Cleveland
Ladner Rd

Dolar
General

Swilley
Rd

Front porch

ice bin

magnolia
gas

Loves
Pharmacy

meo

Udillia Rd

J P
Ladner Rd

Cable
Bridge Rd

RECEIVED
JAN 23 2017
BY OLWR