

STATE WELL REPORT

Part 1 Driller's Log

Mississippi Department of Environmental Quality
Office of Land and Water Resources
P.O. Box 2309
Jackson, MS 39225-2309
(601)961-5555
(601)961-5228 (fax)

For Office Use Only:

Well #: JA28
Aquifer: _____
E-Log #: _____

County: Harrison
Permit #: 0239
Driller: Mc Gill Pump & Well
Date drilling completed: 2-9-18

State Law requires that this report be prepared by the license holder responsible for the work and filed with the Department at the above address within 30 days of completion of drilling of the well or borehole.

Well Owner Information <small>(Landowner if borehole is not for a water well)</small>	Well or Borehole Location
Owner Name: <u>Sacoma Global Quality Construction</u>	Latitude: <u>30° 27' 50.7" N</u> Longitude: <u>89° 20' 4.2" W</u> <u>30-27-51</u> <u>89-20-04</u>
Mailing Address: <u>12248 Edwin Ladner Rd</u>	Method of Lat/Long (check one): Conventional Survey _____ USGS quad _____, Hand-held GPS <input checked="" type="checkbox"/> , Survey-grade GPS _____
<u>Pass Christian MS 39571</u>	<u>NE 1/4 SW 1/4, Sec 6 T 75 R 13W</u>
City State Zip Code	<u>9</u> Miles <u>NORTH</u> of <u>DELISLE</u>
Telephone No. <u>(228) 297-8894</u>	(Distance) (Direction) (Nearest Town)

Well / Borehole Data

Date drilling started: 2-8-18 Date drilling completed: 2-9-18 Hole depth: 560 Hole diameter: 2"

Location of the source of any surface water used for drilling: well water

Method of dosing and volume of Chlorine used in drilling and development: NA

Logs run (check all applicable): log run Electric Gamma Ray Density Sonic Neutron Other: NO LOG RUN

Name of organization running log(s): NA

Purpose of borehole (check one): Water Well Geotechnical/Geological Investigation Ground Source Heat Pump
 Seismic Survey Other (describe) _____

If drilling is not related to water well construction, skip the remainder of this block

Purpose of Well (check all applicable): Home Industrial Public Supply Irrigation Fish Culture

Other (describe): _____

If a flowing well, method of flow regulation: Valve _____ Other (describe) Back wash valve

Static Water Level: 100 feet above or below land surface Date measured: 2-9-18
(check one)

Method of measurement (check one) Steel tape Electric tape Air line Other (describe): _____

Well depth: 560 Well grouted to a depth of: 10 feet Type of grout (check one) Neat Cement Bentonite Mix

Casing length: 540 feet Casing diameter: 2 inches Type of casing: PVC

Screen length: 20 feet Screen diameter: 2 inches Type of screen: PVC

Screen slot size: .006 inches Setting depth: From 540 feet to 560 feet

Type of completion (check all applicable) gravel packed Underreamed Open hole Natural Development

Other (describe): _____

Top of lap pipe or reduction in casing: 0 feet


If telescoped or more than one screen, describe on next page

RECEIVED
MAR 12 2018
BY OLWR

NEEDS
market
place
Cable
Bridge
Road


Vidalia Rd

Buckshots Loves
pharmacy.
Liquor
place

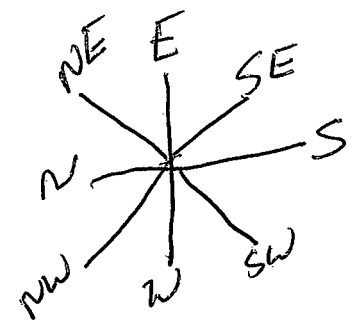

SP Ladner Rd

RECEIVED
MAR 12 2018
BY OLWR

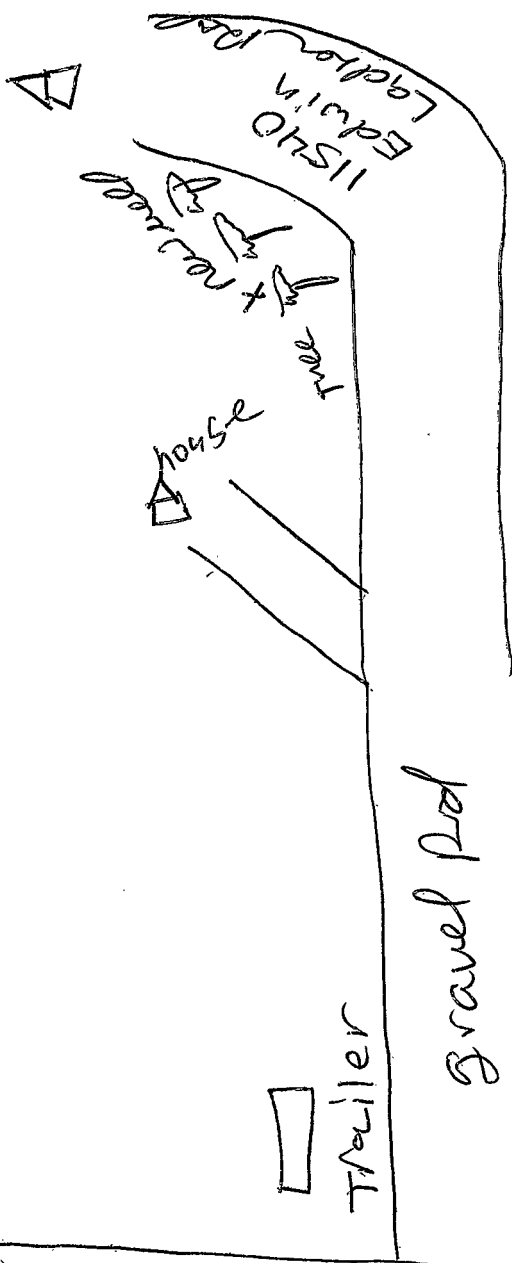

Edwin Ladner Rd