County: <u>Harrison</u> Permit #: Driller: <u>0-785</u> Date drilling completed: <u>8-29-1</u> 8	STATE WELL REPORT Part 1 Driller's Log Mississippi Department of Environmental Qua Office of Land and Water Resources P.O. Box 2309 Jackson, MS 39225-2309 (601)961-5555	For Office Use Only: ality Well #:
Department at the above address with	(601)961-5228 (fax) be prepared by the license holder responsible thin 30 days of completion of drilling of the	well or borehole.
Well Owner Information (Landowner if borehole is not for a Owner Name: <u>Roy Malley</u>	Latitude: 30. 445 318 30 - 26 42	Borehole Location Longitude: 89,301824 Boren 18 - C 7 ck one): Conventional Survey,


Owner Name:	30-26-43 80-01				
Mailing Address: Parcel 0208-09-011.	Method of Lat/Long (check one): Conventional Survey, 014				
Hidden Valley Rd	USGS quad, Hand-held GPS, Survey-grade GPS				
Pass Christian MS. 39571 City State Zip Code	<u>SE 4 SW 4, Sec 9 T 75 R 13W</u>				
City State Zip Code					
Telephone No. ()	Miles of (Distance) (Direction) (Nearest Town)				
Well / Ba	orehole Data				
	8-29 Hole depth: 410 Hole diameter: 5^4				
Location of the source of any surface water used for drillin	ıg:				
Method of dosing and volume of Chlorine used in drilling an	nd development:				
Logs run (check all applicable): Ilog run Electric Gamm	na Ray Density Sonic Neutron Other:				
Name of organization running log(s):					
Purpose of borehole (check one): Water Well	cal/Geological Investigation Ground Source Heat Pump				
Seismic Survey Other (describe)				
If drilling is not related to water well co	onstruction, skip the remainder of this block EVED				
Purpose of Well (check all applicable): Home Industria					
Other (describe):					
If a flowing well, method of flow regulation: Valve	Other (describe)				
Static Water Level:feetabove orbelow] land surface Date measured:9-29-11					
Method of measurement (check one) Steel tape Electric tape Air line Other (describe):					
Well depth: <u>410</u> Well grouted to a depth of: <u>10</u> feet Type of grout (check one) Neat Cement Bentonite Mix					
Casing length: <u>790</u> feet Casing diameter: <u>190 - 21</u> inches Type of casing: <u>PUC</u>					
Screen length: <u>20</u> feet Screen diameter:					
Screen slot size:inches Setting depth:	From <u>390</u> feet to <u>410</u> feet				
Type of completion (check all applicable) ravel packed Underreamed Open hole Natural Development					
Other (describe):					
Top of lap pipe or reduction in casing:feet					
If telescoped or more than one screen, describe on next page					

County: Harrison	
Permit #:	

For Office Use Only:

The sketch below only required for water wells

If well telescopes, show depths on sketch.

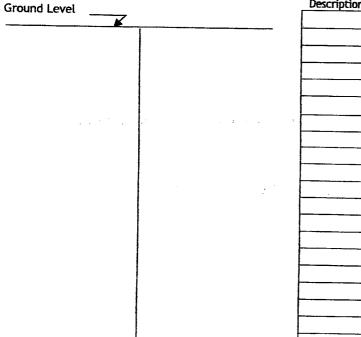

Description of	formations	encountered	must be	provided	for all	wells
and boreholes	unless spec	ifically exen	npted by r	regulation	IS	

Description of Formations Encountered	From (depth)	To (depth)
clay	Ground level	10
	10	30
- Clay	30	120
Sand	120	145
Clarf	145	280
Suad	280	290
clay	290	750
<u> </u>		
Sand	350	410
	╂────┤	
	<u> </u>	
	 	
	+	

If more than one screen, show location of each on sketch

 Sketch the property layout and include the following:

 1) the well location

 2) any permanent structures on the property that may aid in locating the well

 3) any roads, power lines, or other items that may aid in locating the property and the well

 4) north arrow

 If the well location

 Question Question Question

 <td

Form: OLWR-SWR-1B (4/13)

	STATE WE	LL REPORT	
County: HARCISON] I	Part 2	For Office Use Only:
Permit #:	Pump Installer's Completion Report Mississippi Department of Environmental Quality Office of Land and Water Resources P.O. Box 2309		
Driller: <u>P-75'9</u>			Well #: <u>J437</u>
Date completed: 8-30-18			1-15-
Copy information from block on Part 1	(601	MS 39225-2309)961-5210	Aquifer:
	(601) 30	60-0535 (fax)	
This part of the report must be complete	ed by a licensed water we	ell contractor or a licensed pur	np installer. A copy of Part 1
of the report must be attached and both Well Owner Informat			ocation 89-18-07
Owner Name: Roy Malley		30,445718	gitude: 89.30 kg 2 4 °
Mailing Address: Parcel 020	1 - 90 - 011 - 01		gitude: 10 M & Y
Hills it is			
Hidden Valley Rd	U		PS, Survey-grade GPS
Pass Christian MS. City State	Zip Code	55 14 51 14, Sec_	9 T 75 R 13W
Telephone No. ()	Carrier Carrier	Mileso Distance) (Direction)	f
		Distance) (Direction)	(Nearest Town)
	Pump Type		
Submersible Turbine Air Lift Centri			
Date Pump Installed: 8-79-1	Rate	ed Pump Capacity:	Gallons Per Minute
s This Pump (check one); New Re	paired Replacement		
/	Power Type	(check one)	
		-	
Electric Diesel Gasoline Natural Gas	Tractor PTO Windm	ill Other (describe):	
		ill Other (<i>describe</i>): ノのンfeet Number	
	Setting Depth:	/ රට feet Number	
Horse Power Rating of Motor:/	Setting Depth: Pump Test Data for	Non Flowing Well	of Stages:
Horse Power Rating of Motor:/	Pump Test Data for	Non Flowing Well	of Stages: um 4 hours): hours
Horse Power Rating of Motor:/ Date Well Tested: Static Water Level (A):Fee	Pump Test Data for	Non Flowing Well Duration of Pump Test (minim Pumping Water Level (B):	of Stages: um 4 hours):hours /00Feet Below Land Surface
Horse Power Rating of Motor: Date Well Tested:	Pump Test Data for Pump Test Data for D t Below Land Surface Feet Below Land Surface	Voc feet Number Non Flowing Well Puration of Pump Test (minim Pumping Water Level (B): Test Pumping Rate:	of Stages:
Horse Power Rating of Motor: Date Well Tested:	Setting Depth: Pump Test Data for D t Below Land Surface Feet Below Land Surface teel tape Electric tape	Image: Non Flowing Well Ouration of Pump Test (minimum Pumping Water Level (B): Image: Test Pumping Rate: Image: Line Intermine Conter (describe):	of Stages:
Horse Power Rating of Motor: Date Well Tested:	Setting Depth: Pump Test Data for D t Below Land Surface Feet Below Land Surface teel tape Electric tape Pump Test Data i	Image: Non Flowing Well Ouration of Pump Test (minimum Pumping Water Level (B): Image: Test Pumping Rate: Image: Line Intermine Conter (describe):	of Stages:
Horse Power Rating of Motor: Date Well Tested:	Setting Depth: Pump Test Data for D t Below Land Surface Feet Below Land Surface teel tape Electric tape Pump Test Data i	Image: Non Flowing Well Ouration of Pump Test (minimum Pumping Water Level (B): Image: Test Pumping Rate: Image: Line Intermine Conter (describe):	of Stages:
Horse Power Rating of Motor: Date Well Tested: & -70 - 18 Static Water Level (A): Fee Drawdown [(B) - (A)]: Fee Method of measurement (check one): S Measured shut in head:feet	Setting Depth: Pump Test Data for D t Below Land Surface Feet Below Land Surface teel tape Electric tape Pump Test Data in	Image: Non Flowing Well Ouration of Pump Test (minimulation of Pump Test (minimulation) Pumping Water Level (B): Pumping Water Level (B): Test Pumping Rate: Air lineOther (describe): For Flowing Well	of Stages:
Horse Power Rating of Motor: Date Well Tested: & -70 - 18 Static Water Level (A): Fee Drawdown [(B) - (A)]: Fee Method of measurement (check one): S Measured shut in head:feet	Setting Depth: Pump Test Data for D t Below Land Surface Feet Below Land Surface teel tape Electric tape Pump Test Data in	Image: Constraint of Pump Test (minimulation of Pump Test (minimulation of Pump Test (minimulation of Pumping Water Level (B): Image: Constraint of Pumping Rate: Image: Constraint of Pumping Rate: Constraint of Pumping Rate: Constraint of Pumping Rate: Image: Constraint of Pumping Rate: Constrate (Constraint of Pumping Rate: Constraint of	of Stages:
Horse Power Rating of Motor:	Setting Depth: Pump Test Data for D t Below Land Surface Feet Below Land Surface teel tape Electric tape Pump Test Data for drawdown of Meter Inst	Image: Non Flowing Well Ouration of Pump Test (minimulation Pumping Water Level (B): Test Pumping Rate:	of Stages:
Horse Power Rating of Motor:	Setting Depth: Pump Test Data for D t Below Land Surface Feet Below Land Surface teel tape Electric tape Pump Test Data f drawdown of Meter Ins	Image: Non Flowing Well Ouration of Pump Test (minimulation Pumping Water Level (B): Test Pumping Rate: Air lineOther (describe): for Flowing Well feet after tallation Meter Serial Number:	of Stages:
Horse Power Rating of Motor:	Setting Depth: Pump Test Data for D t Below Land Surface Feet Below Land Surface teel tape Electric tape Pump Test Data for Meter Inst	100 feet Number Non Flowing Well Duration of Pump Test (minimulation Pumping Water Level (B):	of Stages: um 4 hours):2_hours /00_Feet Below Land Surface /8Gallons Per Minute hours of pumping RECEIVED SEP 17 2018
Horse Power Rating of Motor:	Pump Test Data for Pump Test Data for D t Below Land Surface Feet Below Land Surface teel tape Electric tape Pump Test Data for Meter Inst actor (AF x .001, gal x 1)	feet Number Non Flowing Well Duration of Pump Test (minim Pumping Water Level (B): Test Pumping Rate: Air line Other (describe): for Flowing Well feet after feet after feet after Type of Meter: 1000, etc):	of Stages:
Horse Power Rating of Motor:	Setting Depth: Pump Test Data for D At Below Land Surface Feet Below Land Surface teel tape Electric tape Pump Test Data for Anter Installed by:	feet Number Non Flowing Well Puration of Pump Test (minim Pumping Water Level (B): Test Pumping Rate: Air line Other (describe): for Flowing Well feet after tallation Meter Serial Number: Type of Meter: 1000, etc):	of Stages:
Horse Power Rating of Motor:	Setting Depth: Pump Test Data for D At Below Land Surface Feet Below Land Surface teel tape Electric tape Pump Test Data for Anter Installed by:	feet Number Non Flowing Well Puration of Pump Test (minim Pumping Water Level (B): Test Pumping Rate: Air line Other (describe): for Flowing Well feet after tallation Meter Serial Number: Type of Meter: 1000, etc):	of Stages:
Horse Power Rating of Motor:	Setting Depth: Pump Test Data for Data Below Land Surface Feet Below Land Surface teel tape Electric tape Pump Test Data for Anter Installed by: paired Replacement	100 feet Number Non Flowing Well Duration of Pump Test (minimulation Pumping Water Level (B):	of Stages:
Horse Power Rating of Motor: Date Well Tested: Static Water Level (A): Method of measurement (check one): Method of measurement (check one): Measured shut in head: Meter Manufacturer: Meter Manufacturer: Meter Model Number/Name: Totalizer Register Unit and Multiplier F Installation Date: Installation Date: Installation Date: Important: By submitting the above in For agricultion	Setting Depth: Pump Test Data for D t Below Land Surface Feet Below Land Surface teel tape Electric tape Pump Test Data for Meter Inst actor (AF x .001, gal x 7 Meter installed by: paired Replacement formation you are certified meter installed by:	feet Number Non Flowing Well Puration of Pump Test (minim Pumping Water Level (B): Test Pumping Rate: Air line Other (describe): for Flowing Well feet after tallation Meter Serial Number: Type of Meter: 1000, etc): fying that this meter was installed by the meters is on the MDEQ weight of the MD	of Stages:
Horse Power Rating of Motor: Date Well Tested: Static Water Level (A): Method of measurement (check one): Method of measurement (check one): Measured shut in head: Meter Manufacturer: Meter Manufacturer: Meter Model Number/Name: Totalizer Register Unit and Multiplier F Installation Date: Is This Meter (check one): New Register Important: By submitting the above in For agricultar	Setting Depth: Pump Test Data for Data Below Land Surface Feet Below Land Surface Teel tape Electric tape Pump Test Data in drawdown of Meter Inst actor (AF x .001, gal x 1) Meter installed by: paired Replacement formation you are certifiered wells, a list of appro- ments are true to the b	feet Number Non Flowing Well Duration of Pump Test (minim Pumping Water Level (B): Test Pumping Rate: for Flowing Well feet after tallation Meter Serial Number: 1000, etc): fring that this meter was installed meters is on the MDEQ was est of my knowledge.	of Stages:
Horse Power Rating of Motor: Date Well Tested: Static Water Level (A): Static Water Manufacturer: Meter Manufacturer: Meter Model Number/Name: Statizer Register Unit and Multiplier F Installation Date: Is This Meter (check one):	Setting Depth: Pump Test Data for Data Below Land Surface Feet Below Land Surface Teel tape Electric tape Pump Test Data in drawdown of Meter Inst actor (AF x .001, gal x 1) Meter installed by: paired Replacement formation you are certifiered wells, a list of appro- ments are true to the b	feet Number Non Flowing Well Duration of Pump Test (minim Pumping Water Level (B): Test Pumping Rate: for Flowing Well feet after tallation Meter Serial Number: 1000, etc): fring that this meter was installed meters is on the MDEQ was est of my knowledge.	of Stages:

Form:	OI	WR-	SWR	-74	1411	3