

STATE WELL REPORT

142

County: Harrison
 Permit #: 0239
 Driller: McBill Pumpwell
 Date drilling completed: 11-7-18

Part 1
Driller's Log
 Mississippi Department of Environmental Quality
 Office of Land and Water Resources
 P.O. Box 2309
 Jackson, MS 39225-2309
 (601)961-5555
 (601)961-5228 (fax)

For Office Use Only:

Well #: 5438
 Aquifer: _____
 E-Log #: _____

State Law requires that this report be prepared by the license holder responsible for the work and filed with the Department at the above address within 30 days of completion of drilling of the well or borehole.

Well Owner Information <small>(Landowner if borehole is not for a water well)</small>	Well or Borehole Location
Owner Name: <u>Wade Ladner</u>	Latitude: <u>30° 27' 10.46" N</u> Longitude: <u>89° 17' 16.17" W</u>
Mailing Address: <u>11440 Firetower Rd</u>	Method of Lat/Long (check one): Conventional Survey _____, USGS quad _____, Hand-held GPS <input checked="" type="checkbox"/> , Survey-grade GPS _____
<u>Oss Christian</u> <u>MS</u> <u>39571</u> <small>City State Zip Code</small>	<u>SW 1/4 NW 1/4, Sec 10 T 75 R 13 W</u>
Telephone No. <u>(228) 669-6362</u>	<u>6.4</u> Miles <u>north</u> of <u>DeLisle</u> <small>(Distance) (Direction) (Nearest Town)</small>

Well / Borehole Data

Date drilling started: 11-5-18 Date drilling completed: 11-7-18 Hole depth: 540 Hole diameter: 3 X 2

Location of the source of any surface water used for drilling: well water

Method of dosing and volume of Chlorine used in drilling and development: N/A

Logs run (check all applicable): log run Electric Gamma Ray Density Sonic Neutron Other: NO LOGS

Name of organization running log(s): N/A

Purpose of borehole (check one): Water Well Geotechnical/Geological Investigation Ground Source Heat Pump
 Seismic Survey Other (describe) _____

If drilling is not related to water well construction, skip the remainder of this block

Purpose of Well (check all applicable): Home Industrial Public Supply Irrigation Fish Culture

Other (describe): _____

If a flowing well, method of flow regulation: Valve _____ Other (describe) Back wash valve

Static Water Level: 120 feet above or below land surface Date measured: 11-7-18
(check one)

Method of measurement (check one) Steel tape Electric tape Air line Other (describe): _____

Well depth: 540 Well grouted to a depth of: _____ feet Type of grout (check one) Neat Cement Bentonite Mix

Casing length: 520 feet Casing diameter: 3 X 2 inches Type of casing: PVC

Screen length: 20 feet Screen diameter: 2 inches Type of screen: PVC

Screen slot size: .006 inches Setting depth: From 520 feet to 540 feet

Type of completion (check all applicable) gravel packed Underreamed Open hole Natural Development

Other (describe): _____

Top of lap pipe or reduction in casing: 200 feet

If telescoped or more than one screen, describe on next page

RECEIVED
 NOV 18 2018
 BY OLWR

[Faint, mostly illegible text, possibly a list or report]

RECEIVED
MAY 10 1964
BIA OLMB

[Faint, mostly illegible text, possibly a list or report]

STATE WELL REPORT

Part 2

Pump Installer's Completion Report
 Mississippi Department of Environmental Quality
 Office of Land and Water Resources
 P.O. Box 2309
 Jackson, MS 39225-2309
 (601)961-5210
 (601) 360-0535 (fax)

County: Harrison
 Permit #: 0239
 Driller: mc Gill Pump & Well
 Date completed: 11-7-18
Copy information from block on Part 1

For Office Use Only:

Well #: J438
 Aquifer: _____

This part of the report must be completed by a licensed water well contractor or a licensed pump installer. A copy of Part 1 of the report must be attached and both parts filed with the Department at the above address within 30 days of well completion.

Well Owner Information	Well Location
Owner Name: <u>Wade Ladner</u>	Latitude: <u>30° 27' 10.46" N</u> Longitude: <u>89° 17' 16.17" W</u>
Mailing Address: <u>11440 Firetower Rd</u>	Method of Lat/Long (check one): Conventional Survey _____, USGS quad _____, Hand-held GPS <input checked="" type="checkbox"/> , Survey-grade GPS _____
<u>Oss Christian</u> MS <u>39571</u>	<u>SW 1/4 NW 1/4, Sec 10 T 75 R 13W</u>
City State Zip Code	<u>6.4</u> Miles <u>north</u> of <u>DeLisle</u>
Telephone No. <u>(228) 669-6362</u>	(Distance) (Direction) (Nearest Town)

Pump Type (check one)

Submersible Turbine Air Lift Centrifugal Flowing Well Jet Piston Rotary Other (describe): _____

Date Pump Installed: 11-12-18 Rated Pump Capacity: 15 Gallons Per Minute

Is This Pump (check one): New Repaired Replacement

Power Type (check one)

Electric Diesel Gasoline Natural Gas Tractor PTO Windmill Other (describe): _____

Horse Power Rating of Motor: 1 Setting Depth: 160 feet Number of Stages: 7

Pump Test Data for Non Flowing Well

Date Well Tested: 11-12-18 Duration of Pump Test (minimum 4 hours): 4 hours

Static Water Level (A): 120 Feet Below Land Surface Pumping Water Level (B): 160 Feet Below Land Surface

Drawdown [(B) - (A)]: 5 Feet Below Land Surface Test Pumping Rate: 13 Gallons Per Minute

Method of measurement (check one): Steel tape Electric tape Air line Other (describe): _____

Pump Test Data for Flowing Well N/A

Measured shut in head: _____ feet.

Well yielded _____ GPM with a drawdown of _____ feet after _____ hours of pumping

Meter Installation N/A

Meter Manufacturer: _____ Meter Serial Number: _____

Meter Model Number/Name: _____ Type of Meter: _____

Totalizer Register Unit and Multiplier Factor (AF x .001, gal x 1000, etc): _____

Installation Date: _____ Meter installed by: _____

Is This Meter (check one): New Repaired Replacement


Important: By submitting the above information you are certifying that this meter was installed to manufacturer standards. For agricultural wells, a list of approved meters is on the MDEQ website.

RECEIVED
 NOV 19 2018
 BY OLWR


I HEREBY CERTIFY that the above statements are true to the best of my knowledge.

Michael McGill # 0239 11/16/18 [Signature]
 Print Name of Pump Installer and License No. (if applicable) Date Signature of Pump Installer

Fence line

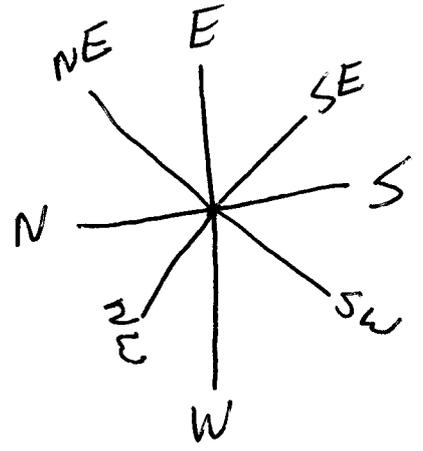

X wall

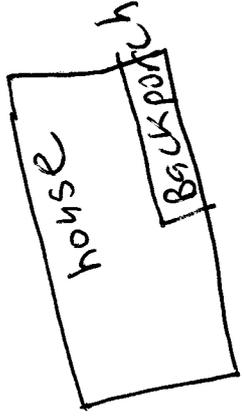

Shiyou Rd

11440 Fire tower rd

Karly Dr

vidalia rd

Fire Tower Rd

RECEIVED
 NOV 19 2018
 BY OLWR

RECEIVED
MAR 17 1968
BAYLOR MED

[Faint, mostly illegible text and markings, possibly bleed-through from the reverse side of the page. Some faint words like "RECEIVED" and "MAR 17 1968" are visible.]