

HARRISON  
 J 2001  
 4-17-75

MISSISSIPPI  
 BOARD OF WATER COMMISSIONERS  
 416 North State Street  
 Jackson, Mississippi 39201

WATER WELL DRILLERS LOG

4/17/1975 Mc Gill Well Works Harrison  
 date well completed firm name county well located

LANDOWNER: Cecil Garner  
Box 661  
Pass Christian, Ms.  
 (mailing address)

description of formations encountered	depth	
	from	to
Clay	0	210
Redd Sand	20	87
White Sand	87	133
Blue Sand	133	168
Coarse Sand	138	200

WELL LOCATION:  
 sec. 12 T. 7 N. R. 13 E.  
8 miles (distance) N of Deale (direction) (nearest town)

WELL PURPOSE: Home  
 (home, irrigation, municipal, industrial)

WELL COMPLETION DATA:

(1) diameter (inches) 2"

(2) total depth (feet) 200

(3) static water level (feet) 32' below top of ground

(4) casing 50' 40' (material) pl. (depth) 190'

         If telescope see back.  
 (size)

(5) screen 10' (length)          (depth to top)

2" (size) 3.5" (material)

(6) pump 1 (HP) 9 (yield gpm)

Electric (type power)

(7) electric log no (yes or no)

         (organization running log)


(8) how well bottom plugged sand shark

DRILLERS REMARKS:         

APR 8 1975  
 MISS. BD. OF WATER COMMISSIONERS

If well telescopes please sketch and show depths.

GROUND LEVEL

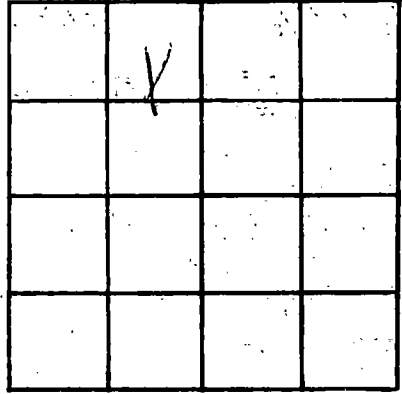

SECTION 15

Please indicate well location X.

ADDITIONAL INFORMATION

If more than one screen, show locations of each on sketch.