

Harrison  
J 2004  
9-24-75

MISSISSIPPI  
 BOARD OF WATER COMMISSIONERS  
 416 North State Street  
 Jackson, Mississippi 39201

WATER WELL DRILLERS LOG

Sept. 24 1975 McNeil Well Works Harrison  
 date well completed firm name county well located

LANDOWNER: Jay O' Shields  
 Rt. 3, Box 470  
 Ross Christian, Miss.  
 (mailing address)

WELL LOCATION:  
 sec. 39 T 4 N R. 13 E 13S  
1 miles N of Delisle  
 (distance) (direction) (nearest town)

WELL PURPOSE: Home  
 (home, irrigation, municipal, industrial)

WELL COMPLETION DATA:

(1) diameter (inches) 2"

(2) total depth (feet) 567

(3) static water level (feet) 45' below  
 top of ground.

(4) casing plastic 557  
 (material) (depth)

- If telescope see back.  
 (size)

(5) screen 10' -  
 (length) (depth to top)

2" 3.5.  
 (size) (material)

(6) pump 12 -  
 (HP) (yield gpm)

electric  
 (type power)

(7) electric log no  
 (yes or no)

-  
 (organization running log)

(8) how well bottom plugged sand  
shank


| description of formations encountered | from       | to         |
|---------------------------------------|------------|------------|
| <u>clay</u>                           | <u>0</u>   | <u>110</u> |
| <u>slush</u>                          | <u>110</u> | <u>131</u> |
| <u>Blue clay</u>                      | <u>131</u> | <u>225</u> |
| <u>course sand</u>                    | <u>225</u> | <u>268</u> |
| <u>Blue clay</u>                      | <u>268</u> | <u>337</u> |
| <u>slush</u>                          | <u>337</u> | <u>372</u> |
| <u>fine sand</u>                      | <u>372</u> | <u>405</u> |
| <u>Blue clay</u>                      | <u>405</u> | <u>498</u> |
| <u>fine sand</u>                      | <u>498</u> | <u>535</u> |
| <u>course sand</u>                    | <u>535</u> | <u>567</u> |

DRILLERS REMARKS:

NOV 25 1975  
 MISS. BD. OF WATER COMM

If well telescopes please sketch and show depths.

GROUND LEVEL

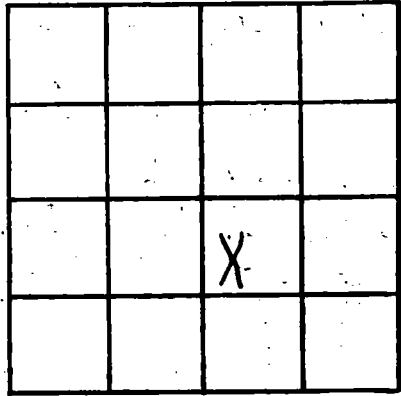

SECTION 39

Please indicate well location X.

ADDITIONAL INFORMATION

If more than one screen, show locations of each on sketch.