

Harrison
Hancock

11-1
6

MISSISSIPPI
BOARD OF WATER COMMISSIONERS
416 North State Street
Jackson, Mississippi 39201

WATER WELL DRILLERS LOG

J 2006
Sept 13, 1976

Sept. 13 1976 date well completed
76 McNeil well works Hancock firm name
Hancock county well located

LANDOWNER: Michael F. J. J. J.
Rt. 2 Box 338-A
Dora Christian, Mo.
(mailing address)

WELL LOCATION:
sec. 7 T. 7 N. R. 13 E.
0.5 miles S.W. of Delisle
(distance) (direction) (nearest town)

WELL PURPOSE: home
(home, irrigation, municipal, industrial)

WELL COMPLETION DATA:
(1) diameter (inches) 2 1/2
(2) total depth (feet) 378'
(3) static water level (feet) 38' below above top of ground.
(4) casing 50% 40 PVC 368' (material) (depth)
If telescope see back.
(5) screen 10' (length) (depth to top)
2" plastic (size) (material)
(6) pump 1 (HP) 12 (yield gpm)
electric (type power)
(7) electric log no (yes or no)
(organization running log)
(8) how well bottom plugged good
shut

description of formations encountered	from	to
clay	0	20
sand	20	87
white clay	87	138
fine sand	138	167
slush	167	192
blue clay	192	238
slush	238	261
blue clay	261	295
slush	295	336
blue clay	336	357
course sand	357	378


RECEIVED
JUL 11 1977

MISS. BD. OF WATER COMMISSIONERS

DRILLERS REMARKS:

If well telescopes please sketch and show depths.

GROUND LEVEL

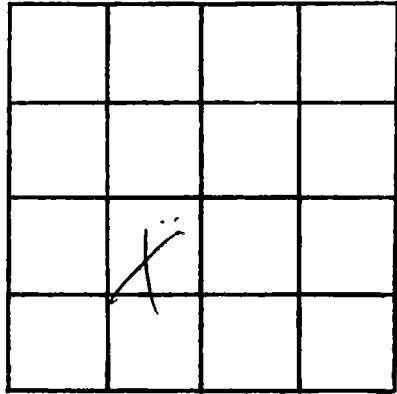

SECTION

7

Please indicate well location X.

ADDITIONAL INFORMATION

If more than one screen, show locations of each on sketch.