

**HARRISON**  
**J 2007**  
**12/30/75**

**MISSISSIPPI**  
**BOARD OF WATER COMMISSIONERS**  
 416 North State Street  
 135 Jackson, Mississippi 39201

**WATER WELL DRILLERS LOG**

12/30/75      19      Sutter Well Works      Harrison  
 date well completed      firm name      county well located

LANDOWNER: <u>Mr. A. E. Abaunza</u> <u>Lazy Acres</u>	description of formations encountered	from	to
Pass Christian, Miss. (mailing address)	Clay	0	10
	Sand	10	85
	Clay-small sand strk	85	485
	Sand	485	535
<b>WELL LOCATION:</b> sec. <u>36</u> T. <u>7</u> N. <u>XX</u> S. R. <u>13</u> E. <u>XX</u> W. <u>3</u> miles NW of <u>Cuevas</u> (distance) (direction) (nearest town)			
<b>WELL PURPOSE:</b> (home, irrigation, municipal, industrial)			
<b>WELL COMPLETION DATA:</b>			
(1) diameter (inches) <u>2" x 4"</u>			
(2) total depth (feet) <u>535'</u>			
(3) static water level (feet) <u>23'</u> below top of ground.			
(4) casing <u>galv.</u> , <u>525'</u> (material) (depth) <u>2" &amp; 4"</u> (size) If telescope see back.			
(5) screen <u>10'</u> <u>525'</u> (length) (depth to top) <u>2"</u> <u>stainless steel</u> (size) (material)			
(6) pump <u>1</u> <u>15</u> (HP) (yield gpm) <u>elec. - submersible</u> (type power)			
(7) electric log <u>no</u> (yes or no)			
(organization running log)			
(8) how well bottom plugged <u>B.P. Valve</u>			
<b>DRILLERS REMARKS:</b>			

MISSISSIPPI  
 BOARD OF WATER COMMISSIONERS  
 1975  
 DECEMBER 31 1975  
 JACKSON, MISSISSIPPI


If well telescopes please sketch and show depths.

GROUND LEVEL

105' of 4" galv. pipe  
L

420' of 2" galv. pipe

10' of 2" s.s. strnr

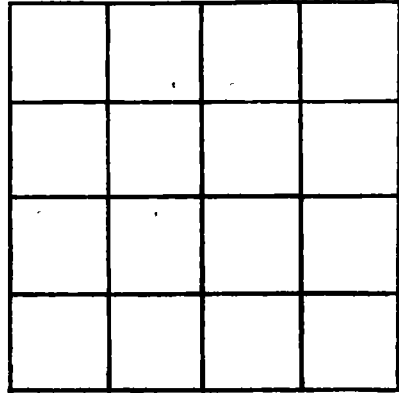

SECTION \_\_\_\_\_

Please indicate well location X.

ADDITIONAL INFORMATION

Lined area for additional information.

If more than one screen, show locations of each on sketch.