

HARRISON

J 2011

3-23-76

MISSISSIPPI BOARD OF WATER COMMISSIONERS
416 North State Street
Jackson, Mississippi 39201

WATER WELL DRILLERS LOG

3-23
date well completed

1976 Penton Well Serv
firm name

Harrison
county well located

LANDOWNER: Lewis Clanton

description of formations encountered	from	to
Surface Clay	0	110
silt	110	150
Sand	150	180
Blue Clay	180	440
Sand	440	490

Rt. 2

Pass Christian, MS -
(mailing address)

WELL LOCATION:

15 sec 15 T 7 R 13 E S W
4 miles S E of Vidalia
(distance) (direction) (nearest town)

WELL PURPOSE: Home
(home, irrigation, municipal, industrial)

WELL COMPLETION DATA:

- (1) diameter (inches) 2
- (2) total depth (feet) 490
- (3) static water level (feet) 36 below top of ground.
- (4) casing 6 5/8" 480
(material) (depth)
- 2" If telescope see back.
(size)
- (5) screen 10' 480
(length) (depth to top)
- 2" S. Steel
(size) (material)
- (6) pump 1/2 5
(HP) (yield gpm)
- Elec
(type power)
- (7) electric log No
(yes or no)

(organization running log)


(8) how well bottom plugged B.W. Valve

DRILLERS REMARKS:

APR 27 1976
MISS. BD. OF WATER COMMISSIONERS

If well telescopes please sketch and show depths.

GROUND LEVEL

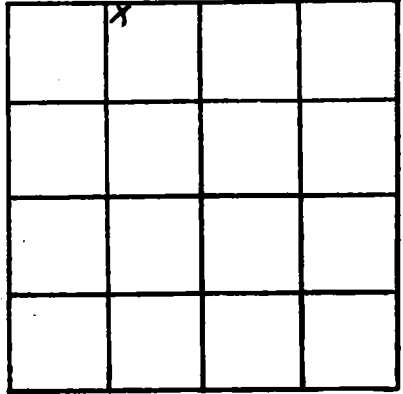

SECTION ~~14~~ 15

Please indicate well location X.

ADDITIONAL INFORMATION

If more than one screen, show locations of each on sketch.