

HARRISON  
J 2021  
12/4/76

MISSISSIPPI  
BOARD OF WATER COMMISSIONERS  
416 North State Street  
135 Jackson, Mississippi 39201

WATER WELL DRILLERS LOG

Dec. 4 1976 ME This well works Harrison  
date well completed firm name Inc. county well located

LANDOWNER: Betty Autry  
Rt. 2, Box 470  
Pass Christian, Ms.  
(mailing address)

description of formations encountered	from	to
Clay	0	81
Red Sand	81	105
Blue Clay	105	192
Slush	192	236
Blue Clay	236	291
Slush	291	315
fine sand	315	341
UNSATURATED SAND	341	372

WELL LOCATION:  
sec. 3 T. 2 N. R. 13 E.  
1/5 ± miles N of Delisle.  
(distance) (direction) (nearest town)

WELL PURPOSE: home  
(home, irrigation, municipal, industrial)


WELL COMPLETION DATA:  
(1) diameter (inches) 2"  
(2) total depth (feet) 372'  
(3) static water level (feet) 90' below above top of ground.  
(4) casing sch. 40, 362' (material) (depth)  
If telescope see back.  
(5) screen 10' (length) (depth to top)  
2" plastic (size) (material)  
(6) pump 1 (HP) 6 (yield gpm)  
electric (type power)  
(7) electric log NO (yes or no)  
(organization running log)  
(8) how well bottom plugged sand shank

DRILLERS REMARKS:

RECEIVED  
JUL 11 1976  
MISS. BD. OF

If well telescopes please sketch and show depths.

GROUND LEVEL

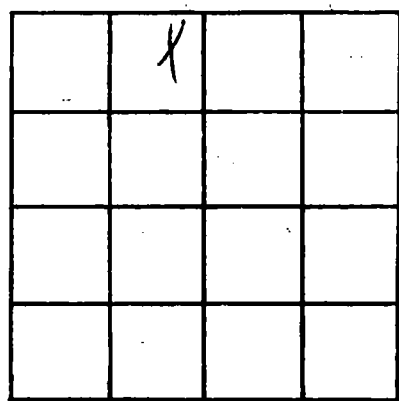

SECTION 3

Please indicate well location X.

ADDITIONAL INFORMATION

Lined area for additional information.

If more than one screen, show locations of each on sketch.