

HARRISON  
J 2023  
4-30-77

MISSISSIPPI  
BOARD OF WATER COMMISSIONERS  
416 North State Street  
Jackson, Mississippi 39201

WATER WELL DRILLERS LOG

April 30 1977 McNeil Well Works, Inc. Harrison  
date well completed firm name county well located

LANDOWNER: B.B. Bailey

Rt. 1, Valdalia Rd.

P.e. Ms.

(mailing address)

WELL LOCATION:

sec. 9 T. 7 N. R. 13 E.  
85 miles NW of Deale  
(distance) (direction) (nearest town)

WELL PURPOSE:

(home irrigation, municipal, industrial)

WELL COMPLETION DATA:

- (1) diameter (inches) 2"
- (2) total depth (feet) 430'
- (3) static water level (feet) 90' <sup>below</sup> top of ground <sup>above</sup>
- (4) casing PVC 40 420'  
(material) (depth)  
- (size) If telescope see back.
- (5) screen 10' -  
(length) (depth to top)  
2" plastic  
(size) (material)
- (6) pump 1 5  
(HP) (yield gpm)  
electric  
(type power)
- (7) electric log no  
(yes or no)  
-  
(organization running log)
- (8) how well bottom plugged sand  
mark

description of formations encountered	from to	
clay	0	68
sand	68	105
white clay	105	146
slush	146	168
fine sand	168	193
blue clay	193	224
slush	224	257
fine sand	257	294
blue clay	294	316
fine sand	316	383
blue clay	383	410
course sand	410	436


DRILLERS REMARKS:

**RECEIVED**

OCT 14 1977

If well telescopes please sketch and show depths.

GROUND LEVEL

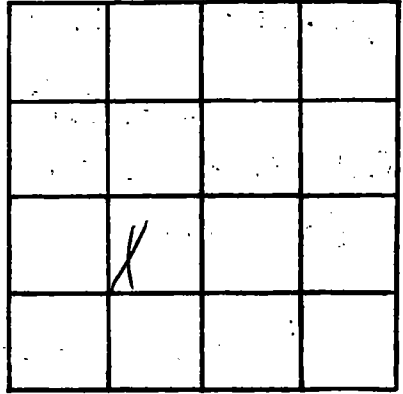

SECTION 9

Please indicate well location X.

ADDITIONAL INFORMATION

Lined area for additional information.

If more than one screen, show locations of each on sketch.