

JACKSON

J 2025

6-3-77

MISSISSIPPI
 BOARD OF WATER COMMISSIONERS
 416 North State Street
 Jackson, Mississippi 39201

135

WATER WELL DRILLERS LOG

Jackson
Harrison

6-3-1977
date well completed

McGee well works
firm name *Inc.*

county well located

LANDOWNER: *Richard Arguelles*

Rt. 1, Box 59

Ocean Springs, Miss.
(mailing address)

WELL LOCATION:

sec. *31* T. *6* N. R. *8* E.
1/4 *3/4* *SE.* of *Intiner*
 (distance) (direction) (nearest town)

WELL PURPOSE: *none*
(home, irrigation, municipal, industrial)

WELL COMPLETION DATA:

- (1) diameter (inches) 2"
- (2) total depth (feet) 800'
- (3) static water level (feet) 18' (below top of ground)
- (4) casing PVC 40 1790'
(material) (depth)
- If telescope see back.
(size)
- (5) screen 10' —
(length) (depth to top)
- 2" S.S.
(size) (material)
- (6) pump 1 12
(HP) (yield gpm)
- electric
(type power)
- (7) electric log no
(yes or no)
- (organization running log)
- (8) how well bottom plugged Sand
Shard

description of formations encountered

from to

Clay	0	38
Silt	38	81
blue clay	81	163
slush	163	194
blue clay	194	287
fine sand	287	316
slush	316	381
blue clay	381	420
fine sand	420	457
blue clay	457	493
fine sand	493	530
blue clay	530	647
slush	647	662
blue clay	662	777
white sand	777	800


RECEIVED

JUL 11 1977

DRILLERS REMARKS:

If well telescopes please sketch and show depths.

GROUND LEVEL

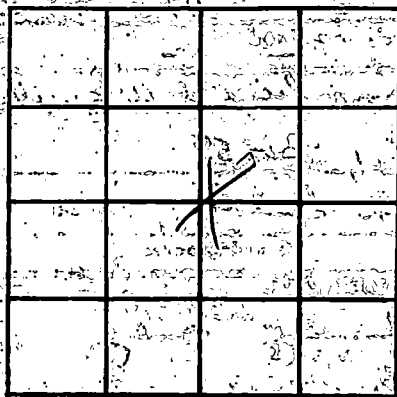

SECTION

3/

Please indicate well location-X.

ADDITIONAL INFORMATION

If more than one screen, show locations of each on sketch.