

HARRISON
 J 2026
 6-7-77

MISSISSIPPI
 BOARD OF WATER COMMISSIONERS
 416 North State Street
 Jackson, Mississippi 39201

WATER WELL DRILLERS LOG

June 7 1977 date well completed
 27 Duncan Well Drilling firm name
 Harrison county well located

LANDOWNER:
 Mitchell Garriga
 Rt 2 Box 268
 Pass Christian, Ms
 (mailing address)

description of formations encountered	from	to
CLAY	0	50
Blue clay	50	260
fine sand	260	290
Coarse sand	290	336

WELL LOCATION:
 sec. 19 T 7 N R 13 E
 3 1/2 miles N.W. of Delisle
 (distance) (direction) (nearest town)

WELL PURPOSE: Home
 (home, irrigation, municipal, industrial)

WELL COMPLETION DATA:

(1) diameter (inches) 2 1/2

(2) total depth (feet) 336

(3) static water level (feet) 42 below top of ground.

(4) casing PVC, 326 (material), (depth)

(size) If telescope see back.

(5) screen 10, 326 (length), (depth to top)
 2" PVC sch. 40 (size), (material)

(6) pump 1, 14 (HP), (yield gpm)
 electric (type power)

(7) electric log (yes or no)

(organization running log)

(8) how well bottom plugged sand


DRILLERS REMARKS:

RECEIVED
 JUN 24 1977

MISS. BD. OF WATER COMM

If well telescopes please sketch and show depths.

GROUND LEVEL

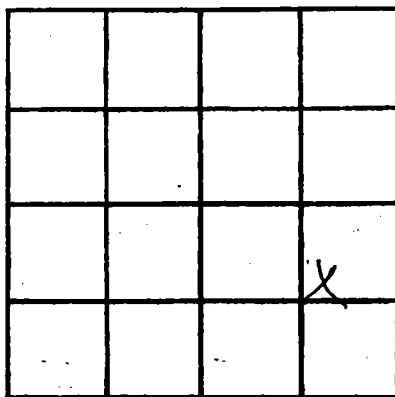

SECTION 19

Please indicate well location X.

ADDITIONAL INFORMATION

If more than one screen,
show locations of each on sketch.