

HARRISON  
 J 2028  
 6/29/77

MISSISSIPPI  
 BOARD OF WATER COMMISSIONERS  
 416 North State Street  
 Jackson, Mississippi 39201

WATER WELL DRILLERS LOG

June 29 1977 *Suncor Well Drilling* *Harrison*  
 date well completed firm name county well located

LANDOWNER: *Biford B. Pearce*  
*Rt. 2 Box 468*  
*Pass Christian, Ms*  
 (mailing address)

WELL LOCATION:  
 sec. 7 T. 10 N. R. 13 E.  
156+ miles SW of Lynch  
 (distance) (direction) (nearest town)

WELL PURPOSE: *Home*  
 (home, irrigation, municipal, industrial)

WELL COMPLETION DATA:

(1) diameter (inches) 2"

(2) total depth (feet) 336

(3) static water level (feet) 50  below  above top of ground.

(4) casing PVC, 326  
 (material) (depth)

       If telescope see back.  
 (size)

(5) screen 10', 326  
 (length) (depth to top)

2", PVC sch 40  
 (size) (material)

(6) pump 8  
 (HP) (yield gpm)

electric  
 (type power)

(7) electric log No  
 (yes or no)

        
 (organization running log)

(8) how well bottom plugged Sand  
Shank


description of formations encountered	from	to
<i>Dirt</i>	<i>0</i>	<i>65</i>
<i>Sand</i>	<i>65</i>	<i>90</i>
<i>Blue Clay</i>	<i>90</i>	<i>147</i>
<i>Grey sand</i>	<i>147</i>	<i>170</i>
<i>Blue Clay</i>	<i>170</i>	<i>290</i>
<i>Grey sand</i>	<i>290</i>	<i>305</i>
<i>Coarse sand</i>	<i>305</i>	<i>336</i>

DRILLERS REMARKS:

RECEIVED  
 OCT - 6 1977

If well telescopes please sketch and show depths.

GROUND LEVEL

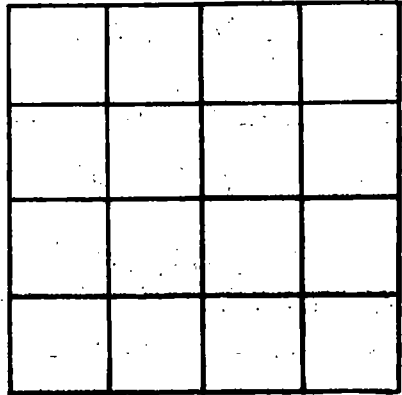

SECTION \_\_\_\_\_

Please indicate well location X.

ADDITIONAL INFORMATION

If more than one screen, show locations of each on sketch.