

HARRISON  
J 2031  
7-13-77

MISSISSIPPI  
 BOARD OF WATER COMMISSIONERS  
 416 North State Street  
 135 Jackson, Mississippi 39201

WATER WELL DRILLERS LOG

July 13 1977 Duncan Well Drilling Harrison  
 date well completed firm name county well located

LANDOWNER Larry Parker  
Rt. 3 Box 389  
Pass Christian, Ms  
 (mailing address)

description of formations encountered	from	to
top soil	0	10
sand	10	25
blue clay	25	180
fine sand	180	210
blue clay	210	250
fine sand	250	280
course sand	280	315

WELL LOCATION:  
 sec 29 T 7 N R 13 E  
23± miles NW of Belike  
 (distance) (direction) (nearest town)

WELL PURPOSE: Home  
 (home, irrigation, municipal, industrial)

WELL COMPLETION DATA:  
 (1) diameter (inches) 2"  
 (2) total depth (feet) 315  
 (3) static water level (feet) 40' <sup>below</sup> <sub>above</sub> top of ground.  
 (4) casing pvc 305  
 (material) (depth)  
 (size) If telescope see back.  
 (5) screen 10' 305  
 (length) (depth to top)  
2" pvc sch. 40  
 (size) (material)  
 (6) pump 1 12  
 (HP) (yield gpm)  
electric  
 (type power)  
 (7) electric log no  
 (yes or no)

(organization running log)  
 (8) how well bottom plugged sand  
shark


DRILLERS REMARKS:

**RECEIVED**  
 OCT - 6 1977

MISS. BO. OF WATER COMMISSIONERS

If well telescopes please sketch and show depths.

GROUND LEVEL

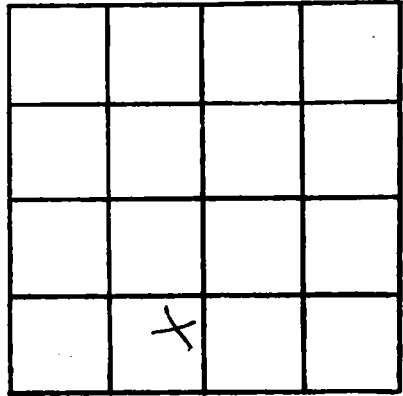

SECTION 29

Please indicate well location X.

ADDITIONAL INFORMATION

If more than one screen, show locations of each on sketch.