

HARRISON
J 2035
11/3/77

MISSISSIPPI
BOARD OF WATER COMMISSIONERS
416 North State Street
Jackson, Mississippi 39201

WATER WELL DRILLERS LOG

Nov. 3 1977 Duncan Well Drilling Harrison
date well completed firm name county well located

LANDOWNER:
Richard B. Pease
Rt. 2 Box 468
Rowe Christian (mailing address) MS.
WELL LOCATION:
sec. 4 T. 10 N. R. 13 E.
10 miles N of Delisle
(distance) (direction) (nearest town)

description of formations encountered	from	to
<u>Red Clay</u>	<u>0</u>	<u>10</u>
<u>Top Sand</u>	<u>10</u>	<u>80</u>
<u>White Clay</u>	<u>80</u>	<u>130</u>
<u>fine sand</u>	<u>130</u>	<u>145</u>
<u>Blue clay</u>	<u>145</u>	<u>290</u>
<u>Rock</u>	<u>290</u>	<u>298</u>
<u>Blue clay</u>	<u>298</u>	<u>325</u>
<u>fine sand</u>	<u>325</u>	<u>350</u>
<u>Course sand</u>	<u>350</u>	<u>370</u>

WELL PURPOSE: Domestic
(home, irrigation, municipal, industrial)


WELL COMPLETION DATA:
(1) diameter (inches) 2"
(2) total depth (feet) 370
(3) static water level (feet) 90' ^{below} _{above} top of ground.
(4) casing 2" pvc 360
(material) (depth)
2 (size) if telescope see back.
(5) screen 10' 360
(length) (depth to top)
2" pvc sch. 40
(size) (material)
(6) pump 1 3004 gpd.
(HP) (yield gpm)
electric
(type power)
(7) electric log (yes or no) _____
(organization running log) _____
(8) how well bottom plugged Sand
bank

DRILLERS REMARKS:

RECEIVED
JAN 25 1978
MISS. Bd. OF WATER COMM.

If well telescopes please sketch and show depths.

GROUND LEVEL

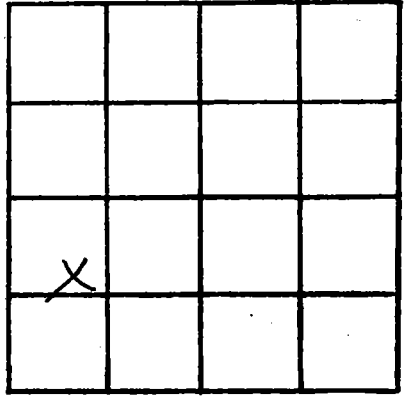

SECTION 4

Please indicate well location X.

ADDITIONAL INFORMATION

If more than one screen, show locations of each on sketch.