

HARRISON

J 2040

4-7-78

MISSISSIPPI BOARD OF WATER COMMISSIONERS
416 North State Street
Jackson, Mississippi 39201

WATER WELL DRILLERS LOG

April 7 1978 date well completed
McNeil Well Works firm name
Harrison county well located

LANDOWNER: John Jones
P.O. Box 175
P.C. Miss. 39571
(mailing address)

WELL LOCATION:
sec. 14 T. 7 N R. 13 E
3 miles N.E. of Oshtemo
(distance) (direction) (nearest town)

WELL PURPOSE:
(home, irrigation, municipal, industrial)

- WELL COMPLETION DATA:
- (1) diameter (inches) 2 1/2
 - (2) total depth (feet) 550
 - (3) static water level (feet) 70' below above top of ground.
 - (4) casing 10' 540'
(material) (depth)
 - (size) If telescope see back.
 - (5) screen 10' -
(length) (depth to top)
2' plastic
(size) (material)
 - (6) pump 1 8
(HP) (yield gpm)
electric
(type power)
 - (7) electric log no
(yes or no)
 - (organization running log)
 - (8) how well bottom plugged Sand
Shark

description of formations encountered	from	to
clay	0	20
red sand	20	78
white clay	78	167
slush	167	231
B. clay	231	252
G. sand	252	288
slush	288	318
B. clay	318	420
Y. sand	420	515
C. sand	515	550


RECEIVED
MAY 4 - 1978

DRILLERS REMARKS:

MISSISSIPPI BOARD OF WATER COMMISSIONERS

If well telescopes please sketch and show depths.

GROUND LEVEL

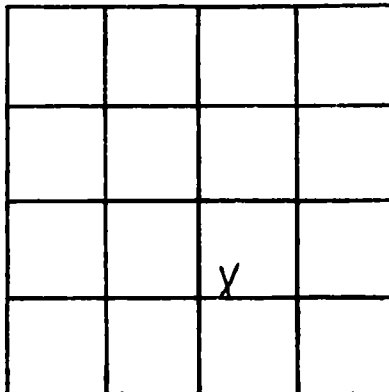

SECTION 14

Please indicate well location X.

ADDITIONAL INFORMATION

If more than one screen, show locations of each on sketch.