

HARRISON

J

10-6-78

2043

Oct. 6 - 1978

MISSISSIPPI
 BOARD OF WATER COMMISSIONERS
 416 North State Street
 Jackson, Mississippi 39201

WATER WELL DRILLERS LOG

date well completed

firm name

county well located

McGill Wellworks Harrison

LANDOWNER: Robert Colstein

Vidalia Rd.

(mailing address)

WELL LOCATION:

sec. 9 T. 7 N. R. 13 E.
 5 miles N of Vidalia
 (distance) (direction) (nearest town)

WELL PURPOSE: home
 (home, irrigation, municipal, industrial)

WELL COMPLETION DATA:

- (1) diameter (inches) 200 - 4" / 330 - 2"
- (2) total depth (feet) 530'
- (3) static water level (feet) 90' below top of ground
- (4) casing sch. 40, 520' (material) (depth)
- (5) screen 10' (length) (depth to top) / 2" (size) plastic (material)
- (6) pump 1-Submerge 25 (HP) (yield gpm) / electric (type power)
- (7) electric log no (yes or no)
- (8) how well bottom plugged sand / shale

description of formations encountered

from

to

Sand-mud	0	20
Mud	20	60
Mud Sand	60	80
Mud	80	100
mud Sand	100	120
l.c. Sand	120	180
Sand-mud	180	220
Mud	220	280
Sand mud	280	320
Sand mud	320	340
Sand	340	360
mud	360	380
Sand	380	400
Sand	400	420


DRILLERS REMARKS:

RECEIVED
 NOV 28 1978

MISS. BD. OF WATER COMMISSIONERS

If well telescopes please sketch and show depths.

GROUND LEVEL

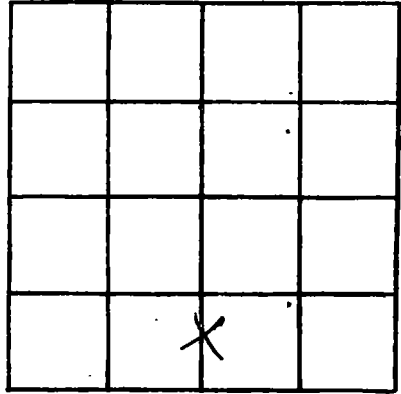

SECTION 9

Please indicate well location X.

ADDITIONAL INFORMATION

If more than one screen, show locations of each on sketch.