

HARRISON
J 2054
5-25-79

MISSISSIPPI
BOARD OF WATER COMMISSIONERS
416 North State Street
Jackson, Mississippi 39201

WATER WELL DRILLERS LOG

May 25 1979 *Concan Well Drilling* *Harrison*
 (date well completed) (firm name) (county well located)

LANDOWNERS: *Barnett Kitchell*
Wright Ave.
Long Beach, Ms.
 (mailing address)

description of formations encountered	from	to
<i>TOP Clay</i>	<i>0</i>	<i>20</i>
<i>TOP Sand</i>	<i>20</i>	<i>40</i>
<i>Blue Clay</i>	<i>40</i>	<i>190</i>
<i>fine sand</i>	<i>190</i>	<i>220</i>
<i>Coarse sand</i>	<i>220</i>	<i>252</i>

WELL LOCATION:
 sec *16* T *7* R *13*
6 miles *N.* of *Star Line*
 (distance) (direction) (nearest town)

WELL PURPOSE: *Home*
 (home, irrigation, municipal, industrial)

- WELL COMPLETION DATA:
- (1) diameter (inches) *2"*
 - (2) total depth (feet) *252'*
 - (3) static water level (feet) *3'* *flow* below above top of ground.
 - (4) casing *PVC* *242'*
 (material) (depth)
 - (size) if telescope see back.
 - (5) screen *10'* *242'*
 (length) (depth to top)
 - 2"* *PVC*
 (size) (material)
 - (6) pump *1* *20*
 (HP) (yield gpm)
 - electric*
 (type power)
 - (7) electric log _____
 (yes or no)
 - _____
 (organization running log)
 - (8) how well bottom plugged *Sand*
Shark

DRILLERS REMARKS:


Miss. Board of Water Comm.

JUN - 5 1979

RECEIVED

If well telescopes please sketch and show depths.

GROUND LEVEL

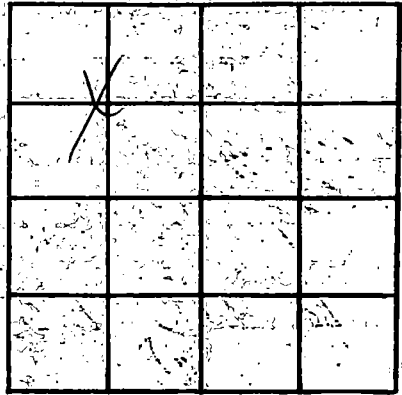

SECTION 16

Please indicate well location X:

ADDITIONAL INFORMATION:

If more than one screen, show locations of each on sketch.