

HARRISON
J
4/27/78
2064

**MISSISSIPPI
BOARD OF WATER COMMISSIONERS**
416 North State Street
Jackson, Mississippi 39201

WATER WELL DRILLERS LOG

April 27 1978 Mc Guel Well Works Harrison
 date well completed firm name county well located

LANDOWNER: Frank Stupack
Rt. 1
Hgt. Ms.
 (mailing address)

WELL LOCATION:
 sec. 6 T. 7 N. R. 13 E.
1 miles NE of Local River
 (distance) (direction) (nearest town)

WELL PURPOSE:
(home) Irrigation, municipal, industrial

- WELL COMPLETION DATA:
- diameter (inches) 2"
 - total depth (feet) 480'
 - static water level (feet) 20' ^{below} above top of ground.
 - casing sch. 40 470'
 (material) (depth)
 (size) if telescope see back.
 - screen 10'
 (length) (depth to top)
2" plastic
 (size) (material)
 - pump 1 15
 (HP) (yield gpm)
electric
 (type power)
 - electric log no
 (yes or no)
 (organization running log)
 - how well bottom plugged gravel
spark

description of formations encountered	from	to
clay	0	30
sand	30	87
slush	87	123
B. clay	123	192
b. sand	192	236
b. slush	236	287
b. sand	287	315
b. clay	315	378
b. sand	378	412
b. clay	412	451
c. sand	451	480

Miss. Board of Water Comm.


AUG 27 1979

DRILLERS REMARKS:

RECEIVED

If well telescopes please sketch and show depths.

GROUND LEVEL

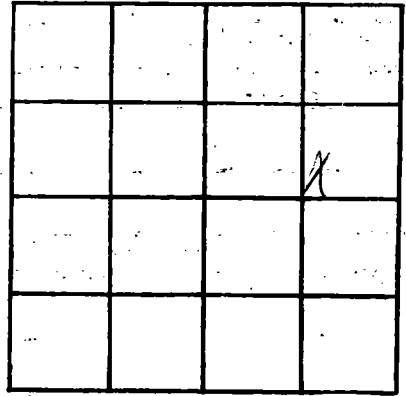

SECTION 6

Please indicate well location X.

ADDITIONAL INFORMATION

If more than one screen, show locations of each on sketch.