

HARRISON
 J 2075
 4-4-80
 April 4 1980
 date well completed

MISSISSIPPI
 BOARD OF WATER COMMISSIONERS
 416 North State Street
 Jackson, Mississippi 39201

WATER WELL DRILLERS LOG

20 Success Well Drilling (firm name)
 Harrison (county well located)

LANDOWNER: Alex Parker
 Rt. 2 Box 347 K2
 Gulfport, Ms. 39503
 (mailing address)

| description of formations encountered | from | to |
|---------------------------------------|------|-----|
| Clay | 0 | 80 |
| Sand | 80 | 105 |
| Blue Clay | 105 | 275 |
| fine sand | 275 | 310 |
| Course Sand | 310 | 332 |

WELL LOCATION:
 sec. 27 T. 7 N. R. 13 E.
 6 miles N.W. of Oshtemo
 (distance) (direction) (nearest town)

WELL PURPOSE: Home
 (home, irrigation, municipal, industrial)


- WELL COMPLETION DATA:
- (1) diameter (inches) 2"
 - (2) total depth (feet) 330 ft
 - (3) static water level (feet) 60' below top of ground
 - (4) casing PVC, 320'
 (material) (depth)
 (size) If telescope see back.
 - (5) screen 10', 320'
 (length) (depth to top)
 2" PVC
 (size) (material)
 - (6) pump _____
 (HP) (yield gpm)
 (type power)
 - (7) electric log _____
 (yes or no)
 (organization running log)
 - (8) how well bottom plugged Sand
 Share

DRILLERS REMARKS:
 No pump installed

DEPT. OF NATURAL RESOURCES
 BUREAU OF LAND & WATER RESOURCES
 MAY 16 1980
 RECEIVED

If well telescopes please sketch and show depths.

GROUND LEVEL

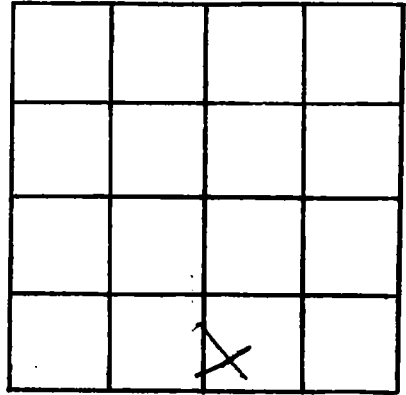

SECTION 29

Please indicate well location X.

ADDITIONAL INFORMATION

If more than one screen,
show locations of each on sketch.