

HARRISON
J 2082
7-6-81

MISSISSIPPI
BOARD OF WATER COMMISSIONERS
416 North State Street
Jackson, Mississippi 39201


WATER WELL DRILLERS LOG

7-6-
date well completed

1981 Ward Well Drg.
firm name

Harrison
county well located

LANDOWNER:	description of formations encountered	from	to
Adam Swanie	Top Soil - clay	0	30
Deshile Rd.	SD	30	42
Deshile Mrs.	clay	42	180
(mailing address)	SD	180	205
WELL LOCATION:	clay - silt	205	250
sec. 33 T 7 N R 13 E	fine SD	250	286
3 miles N/W of Deshile	clay - silt	286	505
(distance) (direction) (nearest town)	loam SD	505	530
WELL PURPOSE: Home			
(home, irrigation, municipal, industrial)			
WELL COMPLETION DATA:			
(1) diameter (inches) 2"			
(2) total depth (feet) 530			
(3) static water level (feet) 4 below top of ground			
(4) casing PVC (material), 520 (depth)			
(size) If telescope see back.			
(5) screen 10' (length), (depth to top)			
2" (size), Stainless Steel (material)			
(6) pump owner (HP), (yield gpm)			
(type power)			
(7) electric log NO (yes or no)			
N/A (organization running log)			
(8) how well bottom plugged BWV			
DRILLERS REMARKS: N/A			

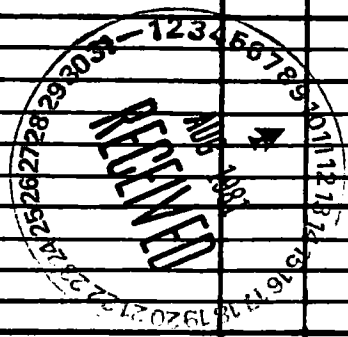

If well telescopes please sketch and show depths.

GROUND LEVEL

SECTION 33

Please indicate well location X.

ADDITIONAL INFORMATION

If more than one screen, show locations of each on sketch.

Handwritten notes and sketches:
A hand-drawn sketch of a well structure is visible in the bottom left corner, showing a vertical shaft with a screen at the bottom. The sketch is annotated with handwritten text, including "200-553888" and "200-553888-100".