

MISSISSIPPI DEPARTMENT OF NATURAL RESOURCES

Bureau of Land and Water Resources

Southport Mall

P.O. Box 10631

Jackson, Mississippi 39209

WATER WELL DRILLERS LOG

Harrison
J
2086

date well completed May 10 1982 firm name Nuncan Well Drilling Harrison county well located _____

LANDOWNER: Arnon Saucier

description of formations encountered

from

to

335 Seal Ave

Mud & Sand	0	25
White & Blue Clay	25	55
fine sand	55	75
Blue Clay	75	85
course sand	85	168

Long Beach, Ms.
(mailing address)

WELL LOCATION:

sec. 30 T. 7 N. R. 13 E
(S) (W)
12 miles N. of Delisle
(distance) (direction) (nearest town)

WELL PURPOSE: Home
(home, irrigation, municipal, industrial)

WELL COMPLETION DATA:

(1) diameter (inches) 2"
(2) total depth (feet) 168 ft.
(3) static water level (feet) 80 below above top of ground.
(4) casing PVC, 158'
(material) (depth)

 if telescope see back.
(size)

(5) screen 10', 158'
(length) (depth to top)
24, PVC
(size) (material)

(6) pump _____ (HP) _____ (yield gpm)
electric
(type power)

(7) electric log _____
(yes or no)

(organization running log)

(8) how well bottom plugged Sand
Shank

DRILLERS REMARKS: Owner has his own pump


DEPT. OF NATURAL RESOURCES
BUREAU OF LAND & WATER RESOURCES

AUG 27 1982

RECEIVED

If well telescopes please sketch and show depths.

GROUND LEVEL

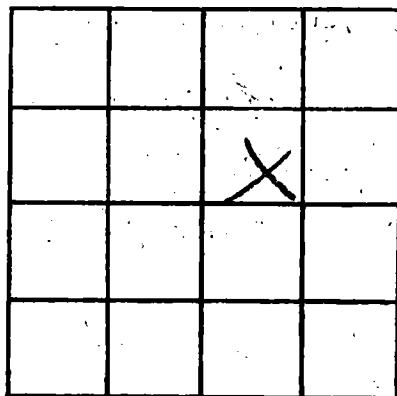

SECTION 30

Please indicate well location X.

ADDITIONAL INFORMATION

If more than one screen, show locations of each on sketch.