

MISSISSIPPI DEPARTMENT OF NATURAL RESOURCES

Bureau of Land and Water Resources

Southport Mall

P.O. Box 10631

Jackson, Mississippi 39209

WATER WELL DRILLERS LOG

Harrison
8
2087

Dec. 10 1982 Duncan Well Drilling Harrison
 date well completed firm name county well located

LANDOWNER: Big Buck Hunting Club
Pt. 3 Box 318
Law Christian, Mo. 39571
 (mailing address)

description of formations encountered	from	to
<u>sand</u>	<u>0</u>	<u>90</u>
<u>Clay</u>	<u>90</u>	<u>110</u>
<u>fine sand</u>	<u>110</u>	<u>120</u>
<u>COARSE SAND</u>	<u>120</u>	<u>147</u>

WELL LOCATION:
 sec 26 T 7 N R 13 E
3 miles N.E. of De Ridder
 (distance) (direction) (nearest town)

WELL PURPOSE: Home
 (home, irrigation, municipal, industrial)

WELL COMPLETION DATA:

(1) diameter (inches) 2"

(2) total depth (feet) 147

(3) static water level (feet) 25' below above top of ground.

(4) casing PVC, 137,
 (material) (depth)
— if telescope see back.
 (size)

(5) screen 10', 137
 (length) (depth to top)
2, PVC,
 (size) (material)

(6) pump 1, 8
 (HP) (yield gpm)
electric
 (type power)

(7) electric log (yes or no) _____
 (organization running log) _____

(8) how well bottom plugged Sand
shark

DEPT. OF NATURAL RESOURCES
 BUREAU OF LAND & WATER RESOURCES


JAN 8 1983

RECEIVED

DRILLERS REMARKS: _____

If well telescopes please sketch and show depths.

GROUND LEVEL

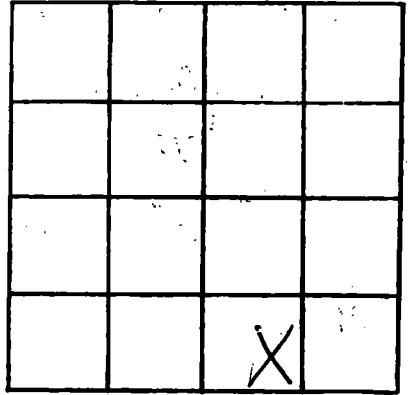

SECTION 26

Please indicate well location X.

ADDITIONAL INFORMATION

If more than one screen, show locations of each on sketch.

26