

MISSISSIPPI DEPARTMENT OF NATURAL RESOURCES
Bureau of Land and Water Resources
 Southport Mall
 P.O. Box 10631
 Jackson, Mississippi 39209
WATER WELL DRILLERS LOG

Harrison
J
2088

April 10 1983 Duncan Well Drilling Harrison
 date well completed firm name county well located

LANDOWNER: Lester Denton
Rt. 2 Box 822
Lass Christian
 (mailing address)

description of formations encountered	from	to
<u>Top Soil</u>	<u>0</u>	<u>18</u>
<u>fine Sand</u>	<u>18</u>	<u>90</u>
<u>Course Sand</u>	<u>90</u>	<u>100</u>

WELL LOCATION:
 sec. 24 T. 7 N. R. 13 E
5 miles N. of Lass Christian
 (distance) (direction) (nearest town)

WELL PURPOSE:
 (home, irrigation, municipal, industrial)

WELL COMPLETION DATA:

- diameter (Inches) 2"
- total depth (feet) 100 ft
- static water level (feet) 30' below above top of ground.
- casing PVC 90
 (material) (depth)
 If telescope see back.
 (size)
- screen 10' 90'
 (length) (depth to top)
2" PVC
 (size) (material)
- pump
 (HP) (yield gpm)
 (type power)
- electric log
 (yes or no)
 (organization running log)
- how well bottom plugged Sand
Shank

DRILLERS REMARKS: Owner had his own pump


DEPT. OF NATURAL RESOURCES
 BUREAU OF LAND & WATER RESOURCES

AUG 12 1983

RECEIVED

If well telescopes please sketch and show depths.

GROUND LEVEL

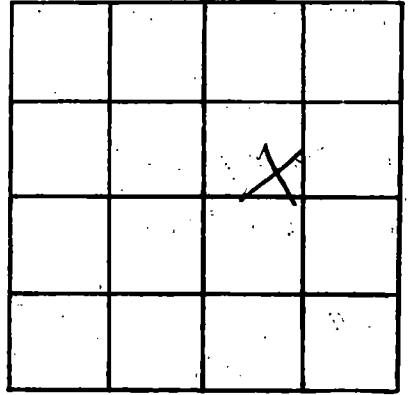

SECTION 24

Please indicate well location X.

ADDITIONAL INFORMATION

If more than one screen, show locations of each on sketch.